


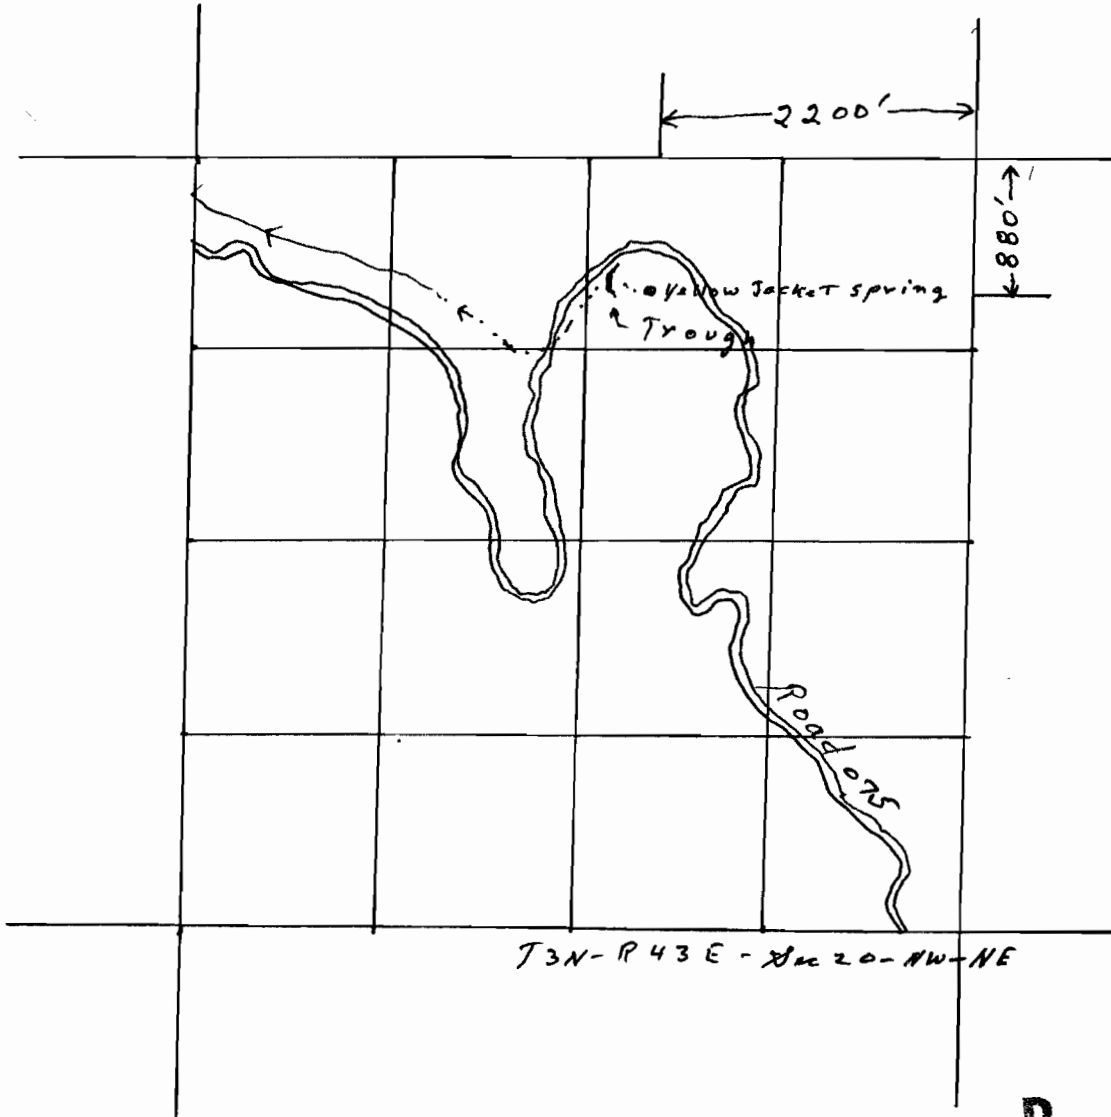

RECEIVED

APR 18 1992
LAND RESOURCES DEPT.
SALEM, OREGON

4 inches = 1 mile

Application No. 65756
Permit No. 49742