N

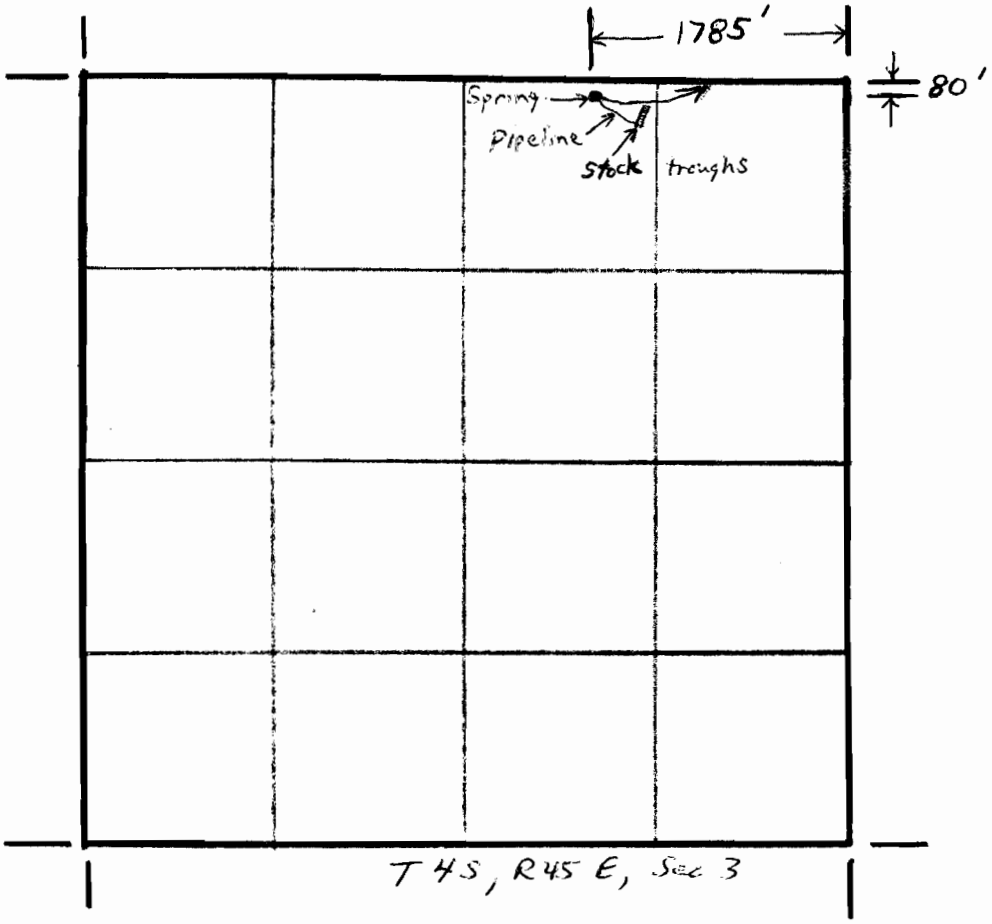

4 Inches = 1 Mile

Application No. 65758
Permit No. 49744

ED
WATER RESOURCES DEPT
SALEM, OREGON