


RECEIVED

SEP 22 1983
WATER RESOURCES DEPT.
SALEM, OREGON

T 7 S R 36 E WM

Section 12

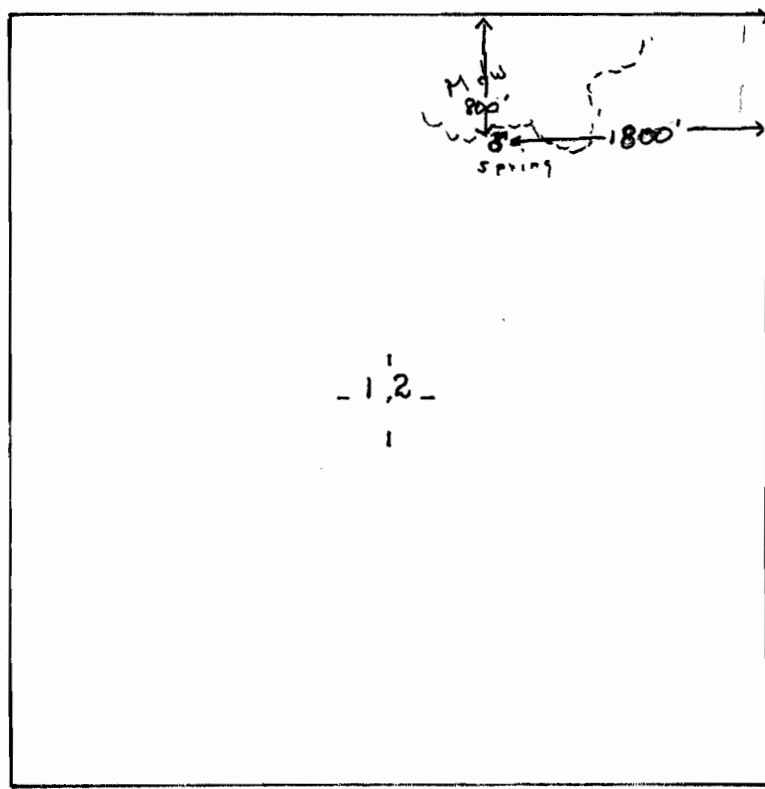

Meadow Springs
Grand Round Camp Ground

NW 1/4 NE 1/4

Application No. 66617
Permit No. 49778

Application No. 66617
Permit No. 49778

RECEIVED
SEP 22 1983
WATER RESOURCES DEPT.
SALEM, OREGON

