


RECEIVED

SEP 22 1983  
WATER RESOURCES DEPT.  
SALEM, OREGON

T10 S R38 E WM

Section 26

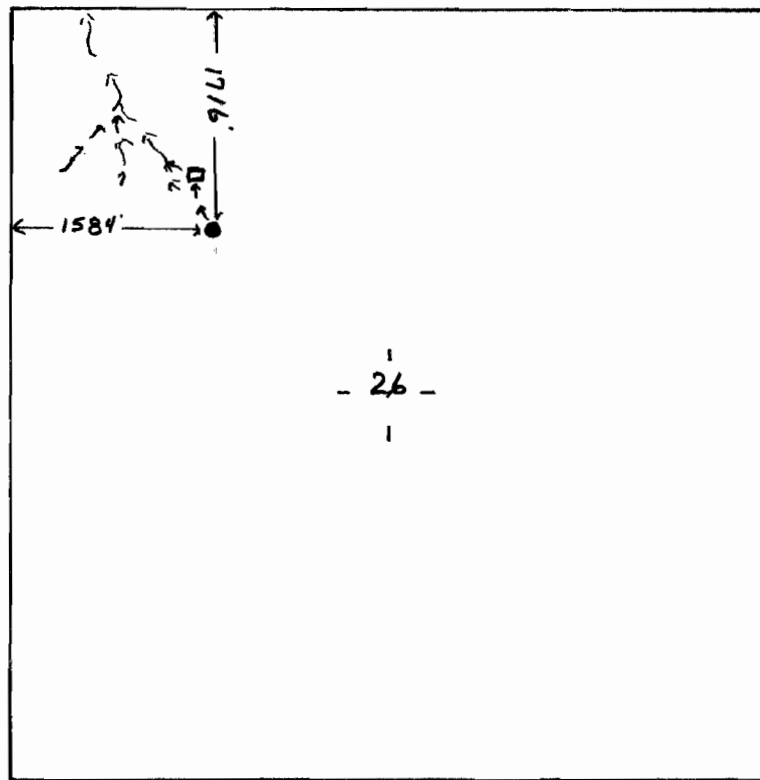

Warrior Spr.

NE 1/4 NW 1/4

Application No. 66618  
Permit No. 49779