


RECEIVED

SEP 22 1983
WATER RESOURCES DEPT.
SALEM, OREGON

T 10 S R 38 E WM

Section 26

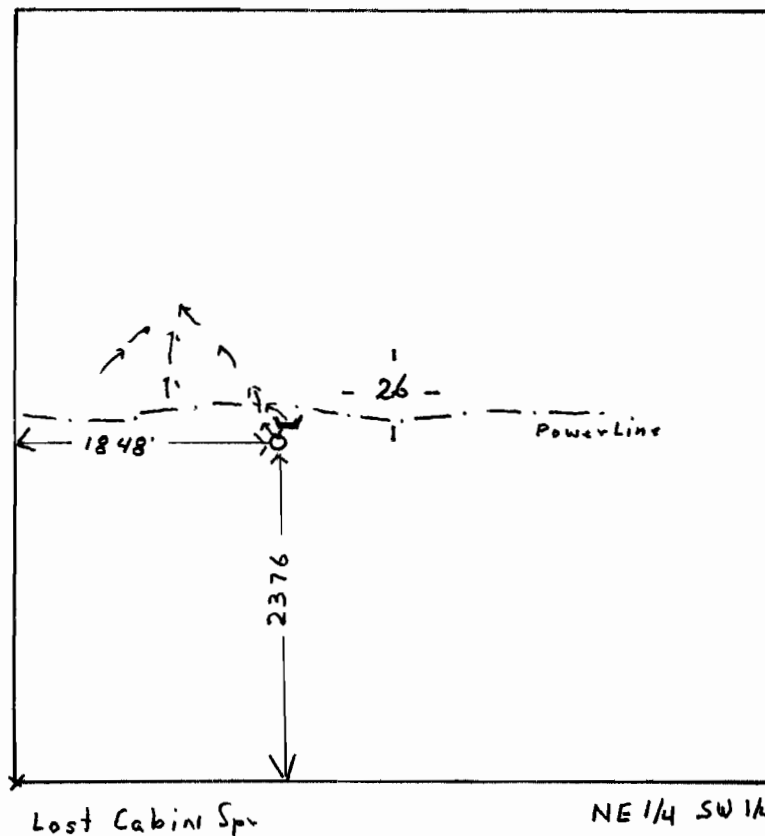

Application No. 66619
Permit No. 49780