


RECEIVED
SEP 22 1983
WATER RESOURCES DEPT.
SALEM, OREGON

T 10 S R 39 E WM

Section 8

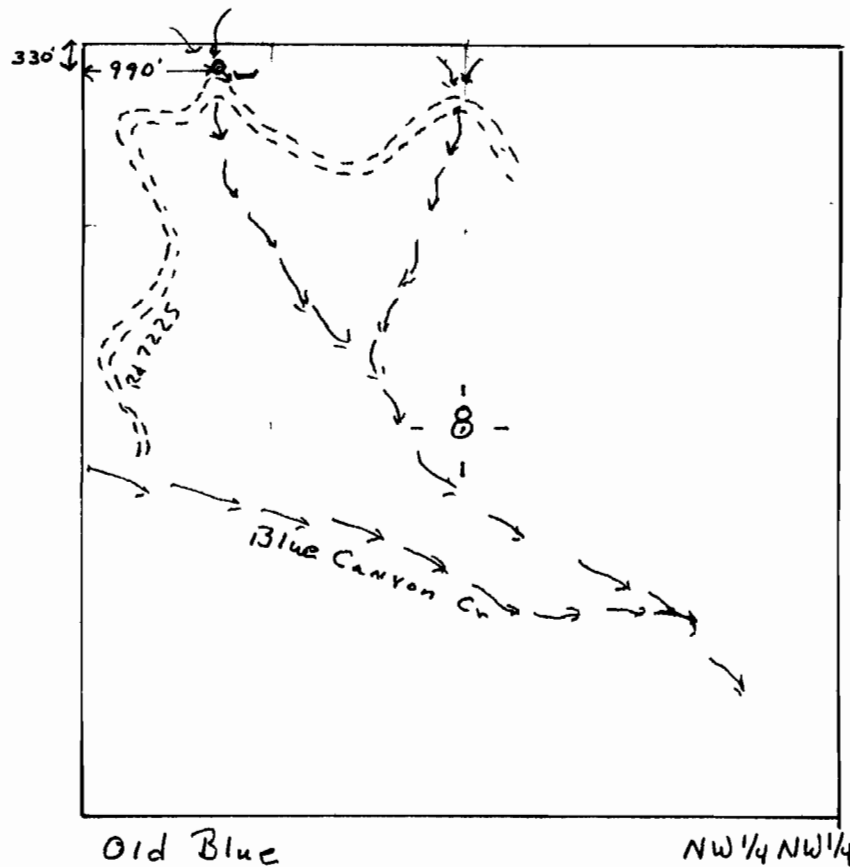

Application No. 66620
Permit No. 49781