


RECEIVED
SEP 22 1983
WATER RESOURCES DEPT.
SALEM, OREGON

T10S R39E WM

Section 5

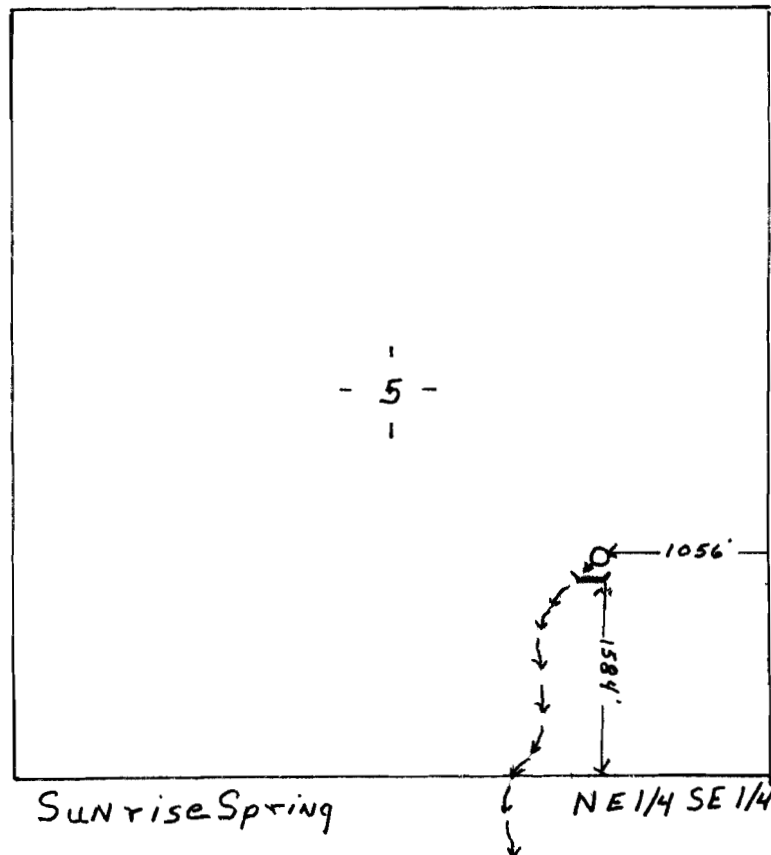

Application No. 66622
Permit No. 49783