


RECEIVED

SEP 22 1983
WATER RESOURCES DEPT.
SALEM, OREGON

T 8 S R 37 E WM

Section 28

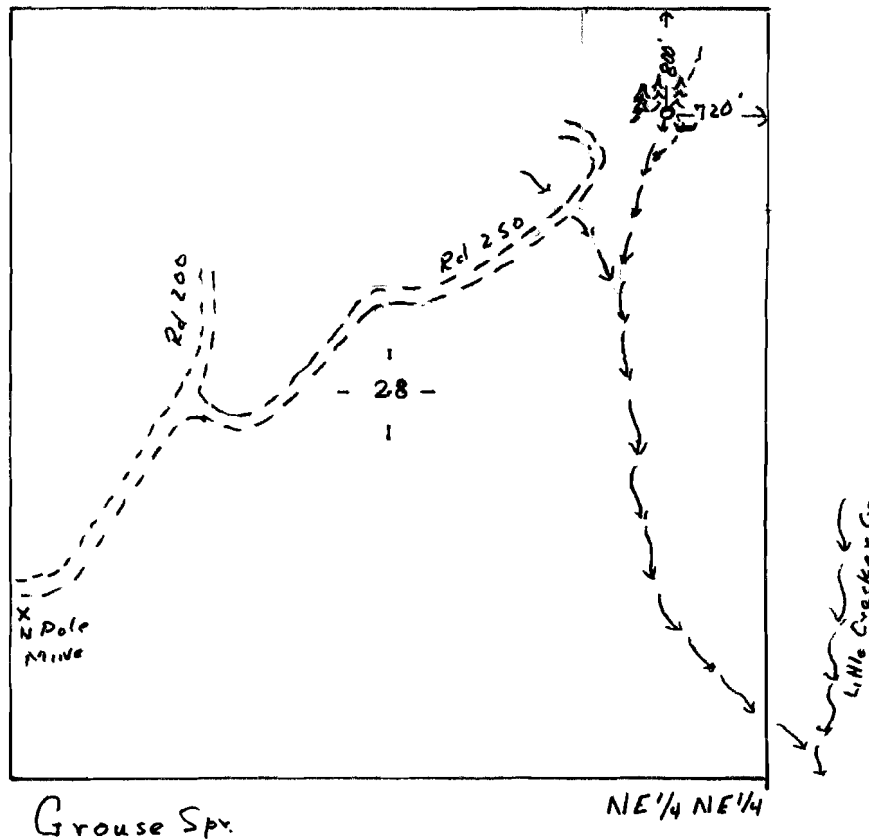

Application No. 66624
Permit No. 49785