


RECEIVED

SEP 2 1983
WATER RESOURCES DEPT.
SALEM, OREGON

T 8 S R 37 E WM

Section 28

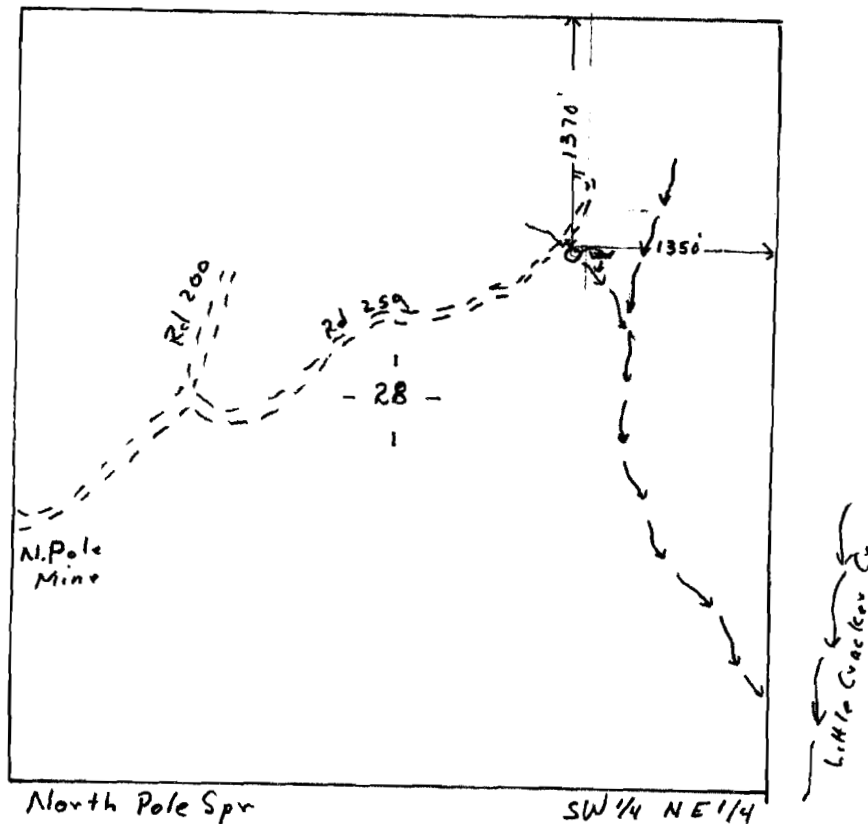

Application No. 66625
Permit No. 49786