


RECEIVED

SEP 2 1983
WATER RESOURCES DEPT.
SALEM, OREGON

T 8 S R 37 E WM

Section 20

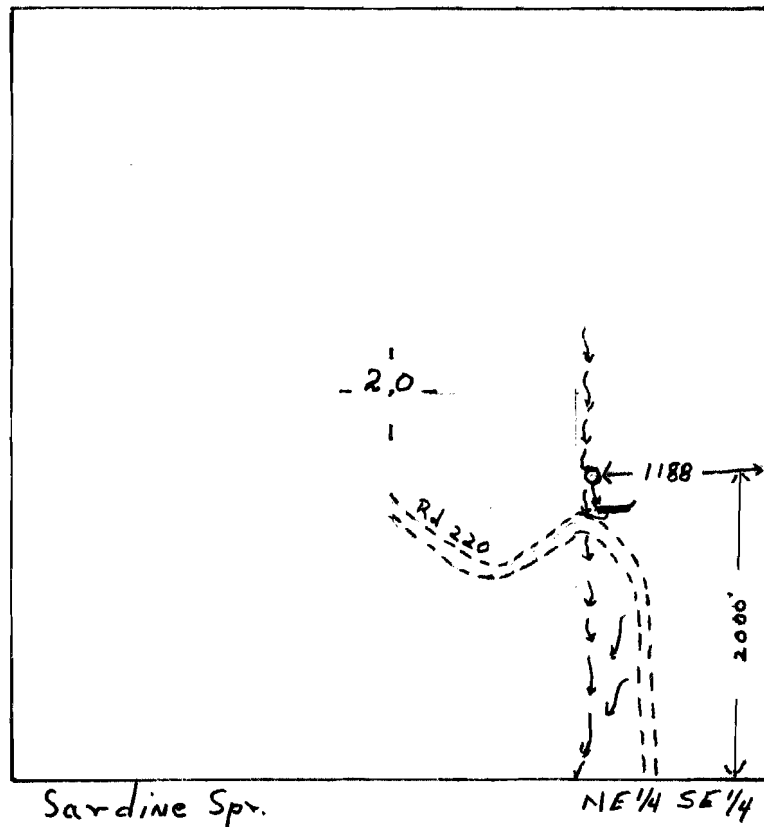

Application No. 66626
Permit No. 49787