


RECEIVED

SEP 2 1983
WATER RESOURCES DEPT.
SALEM, OREGON

T 11 S R 40 E WM

Section 27

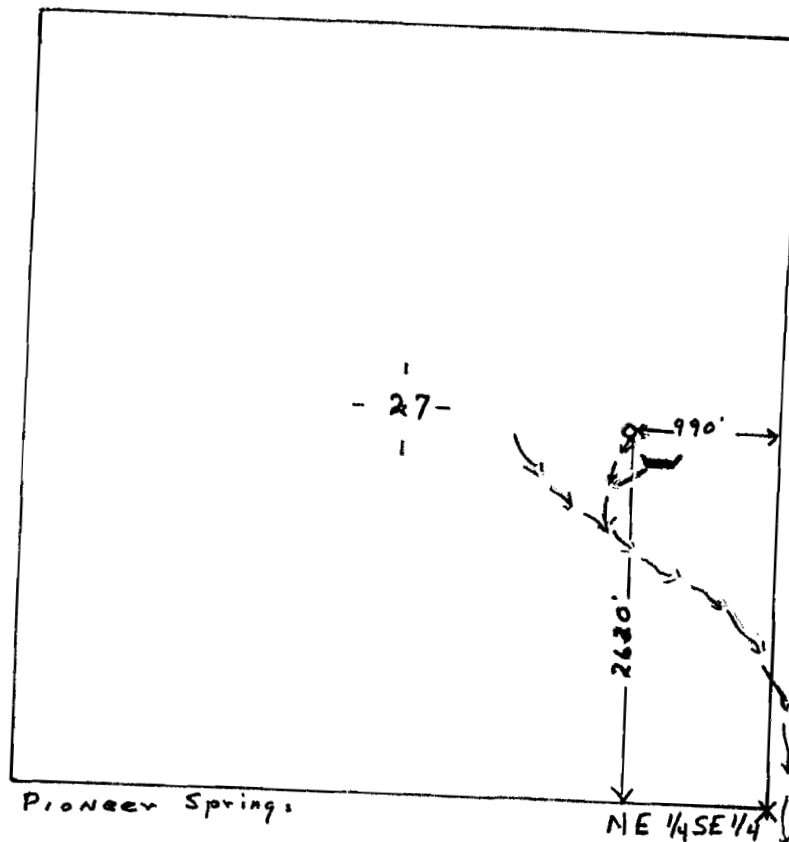

Application No. 66627

Permit No. 49788