


RECEIVED

SEP 2 1983  
WATER RESOURCES DEPT.  
SALEM, OREGON

T 11 S R 40 E WM

Section 26

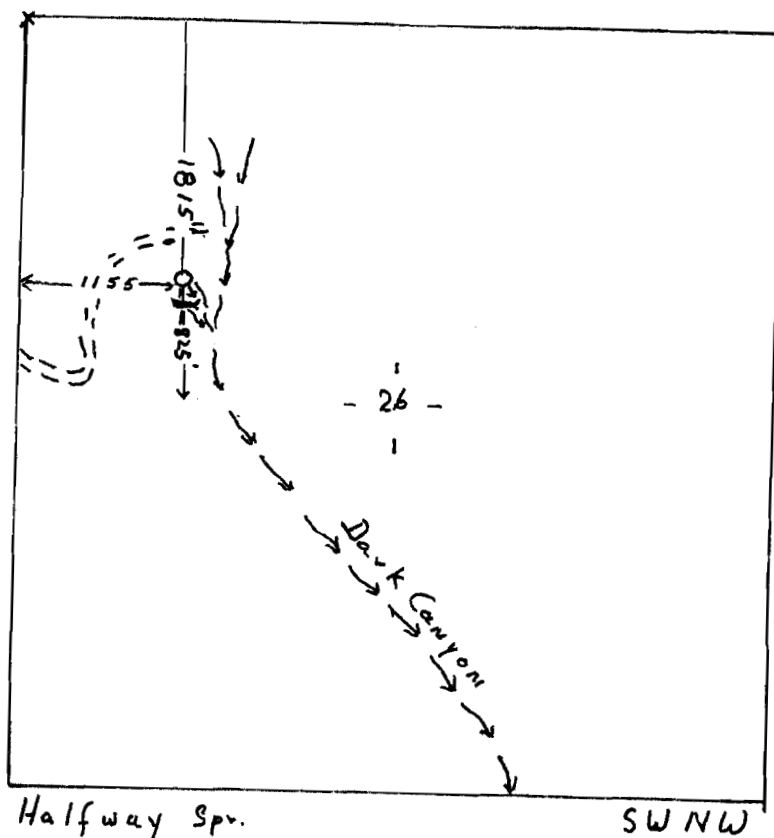

Application No. 66628  
Permit No. 49789