


RECEIVED
SEPT 2 1983
WATER RESOURCES DEPT.
SALEM, OREGON

T 12 S R 39 E WM

Section 12

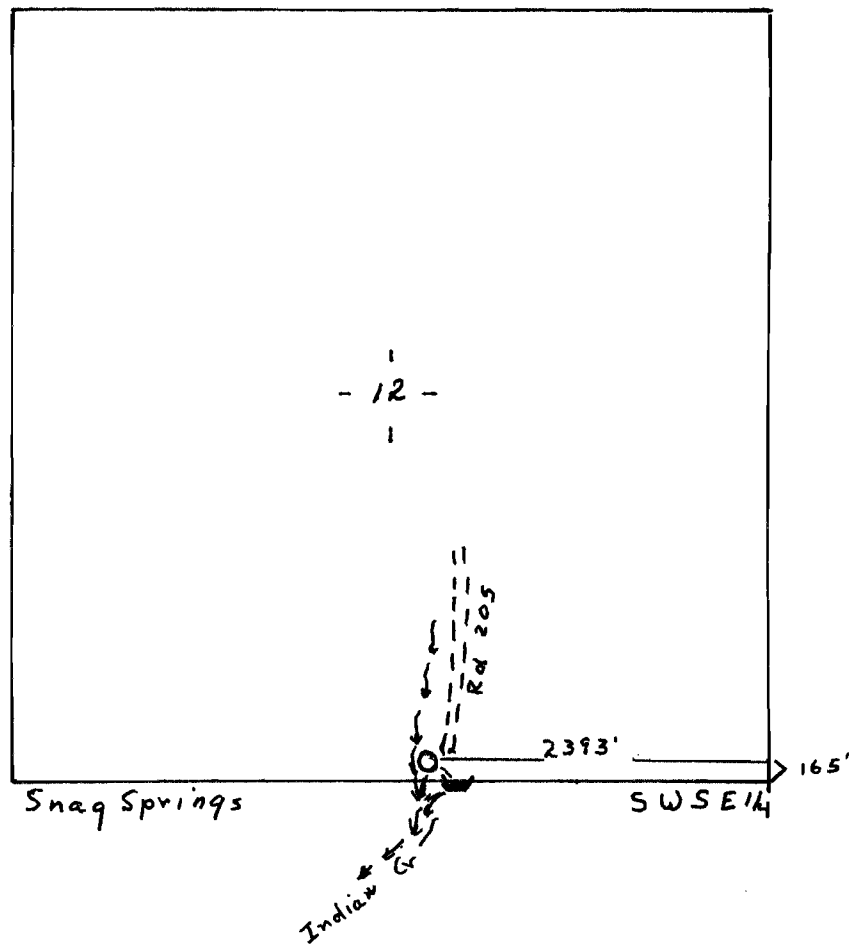

Application No. 66629
Permit No. 49790