


RECEIVED

SEPT 2 1983
WATER RESOURCES DEPT.
SALEM, OREGON

T 10 S R 38 E WM

Section 35

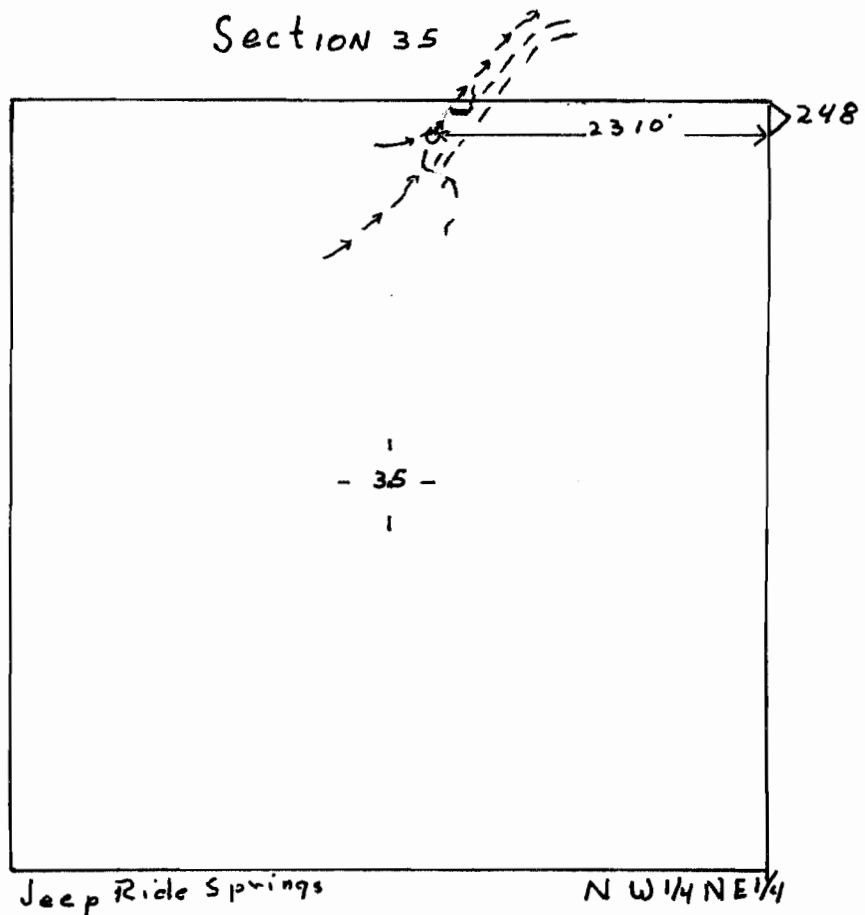

Application No. 66630
Permit No. 49791