


RECEIVED

SEP 2 1983
WATER RESOURCES DEPT.
SALEM, OREGON

T 11 S R 39 E WM

Section 25

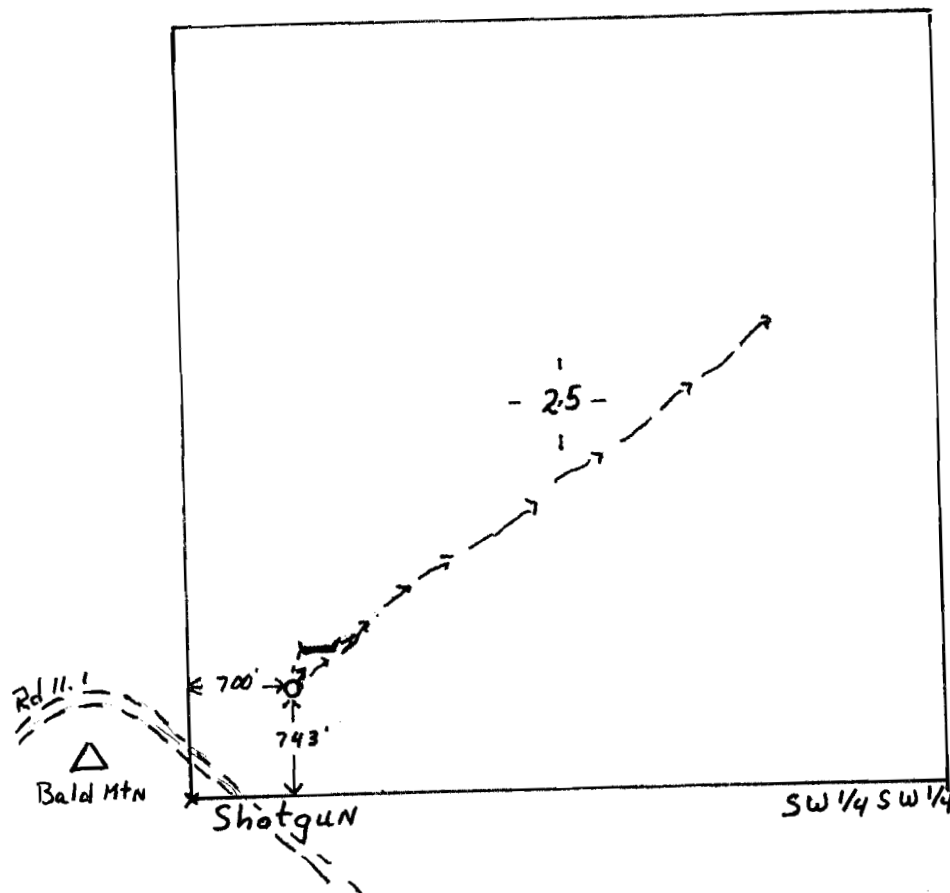

Application No. 66632
Permit No. 49793