


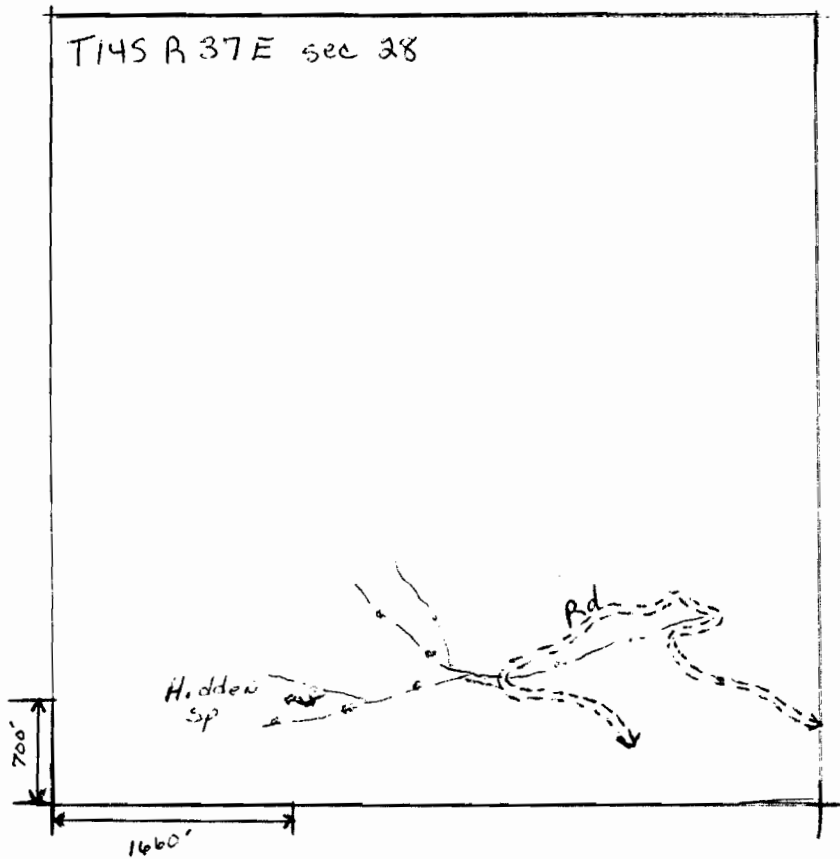

RECEIVED

SEP 3 1983
WATER RESOURCES DEPT.
SALEM, OREGON

Application No. 65936
Permit No. 53153