


RECEIVED

SEP 2 1983
WATER RESOURCES DEPT.
SALEM, OREGON

T11S R39E WM

Section 34

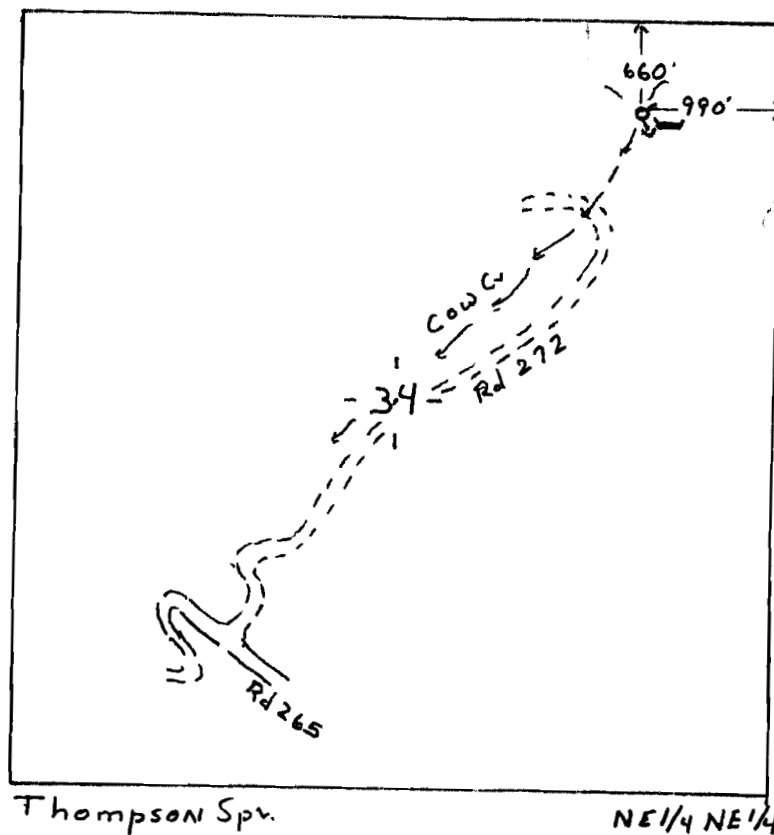

Application No. 66636
Permit No. 49797