


RECEIVED

SEPT 2 1983  
WATER RESOURCES DEPT.  
SALEM, OREGON

T 11 S R 38 E WM

Section 10

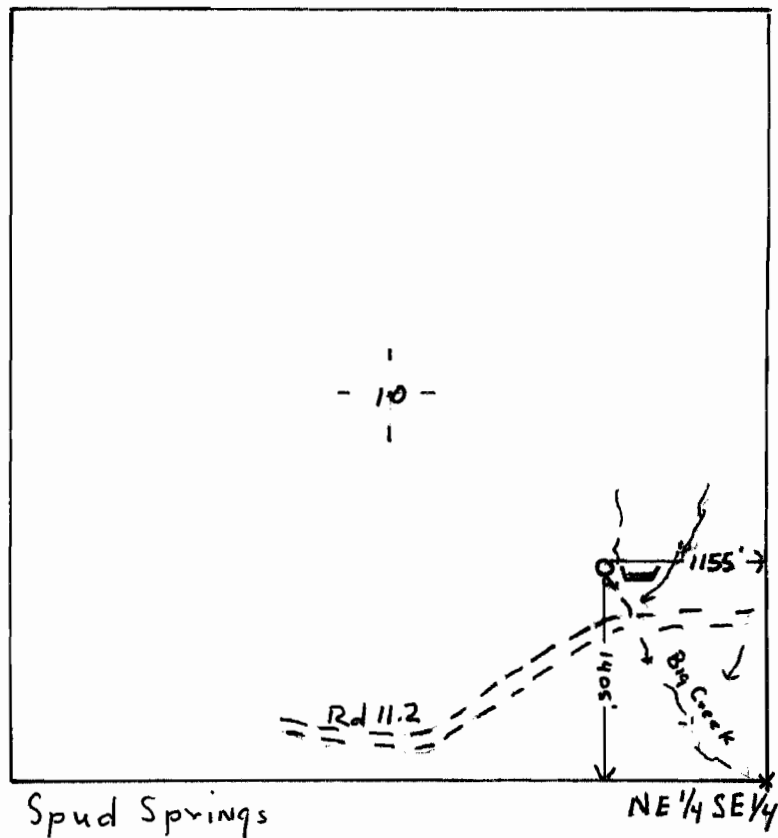

Application No. 66641  
Survey No. 49802