


RECEIVED

SEP 2 1983
WATER RESOURCES DEPT.
SALEM, OREGON

T10 S R38 E WM

Section 27

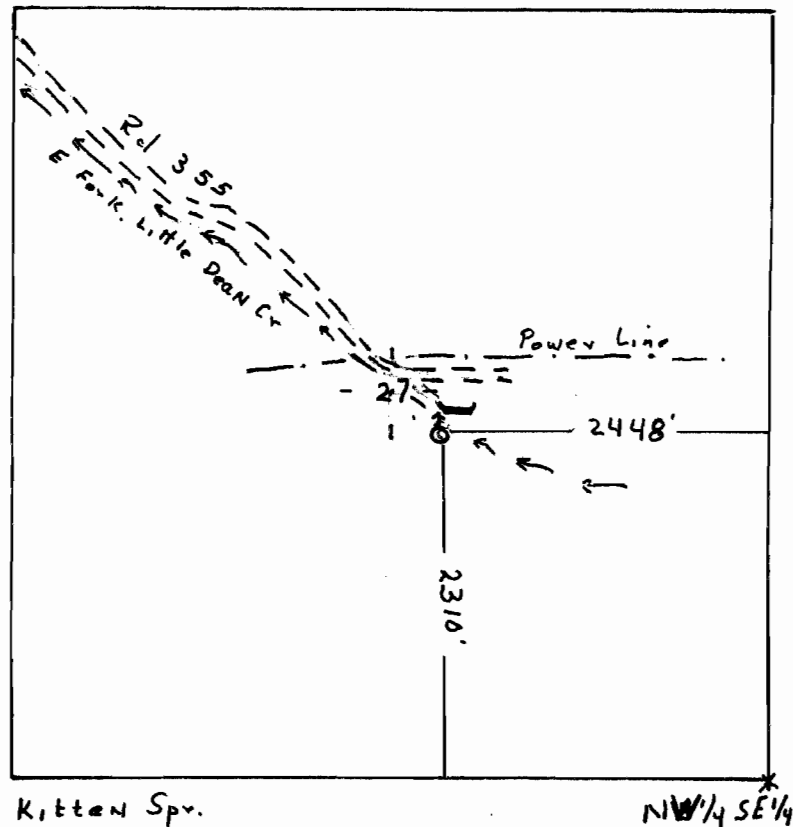

Application No. 66642
Permit No. 49803