


RECEIVED
SEP 2 1983
WATER RESOURCES DEPT.
SALEM, OREGON

T 11 S R 38 E WM

Section 9

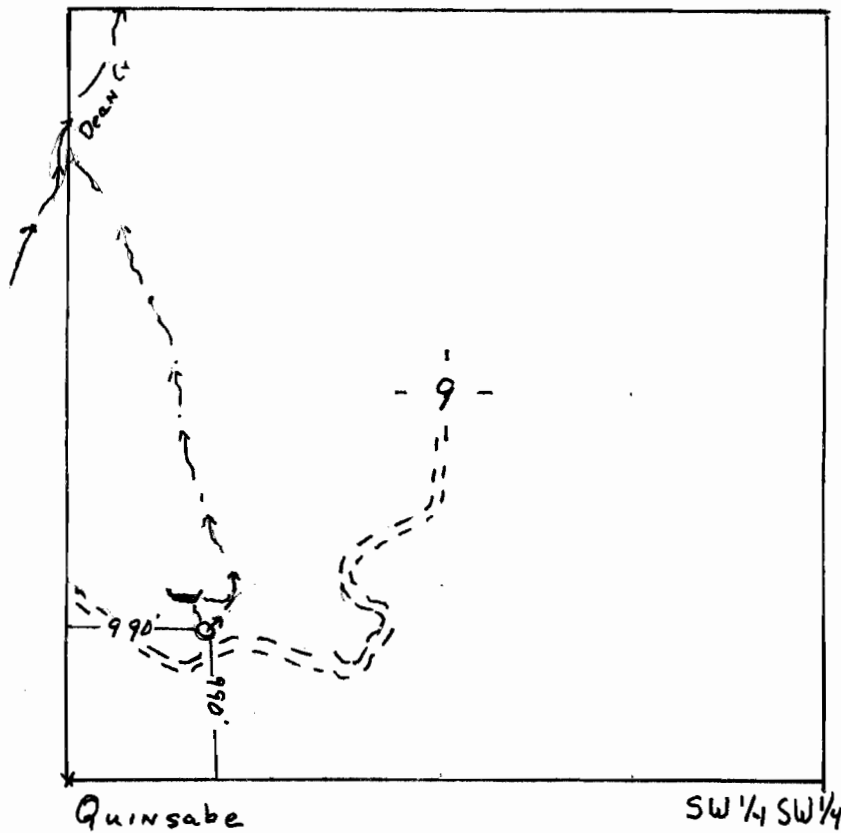

Application No. 66643
Permit No. 49804