


RECEIVED

SEPT 2 1983

WATER RESOURCES DEPT.
SALEM, OREGON

T11 S R38 E W.M.

Section 9

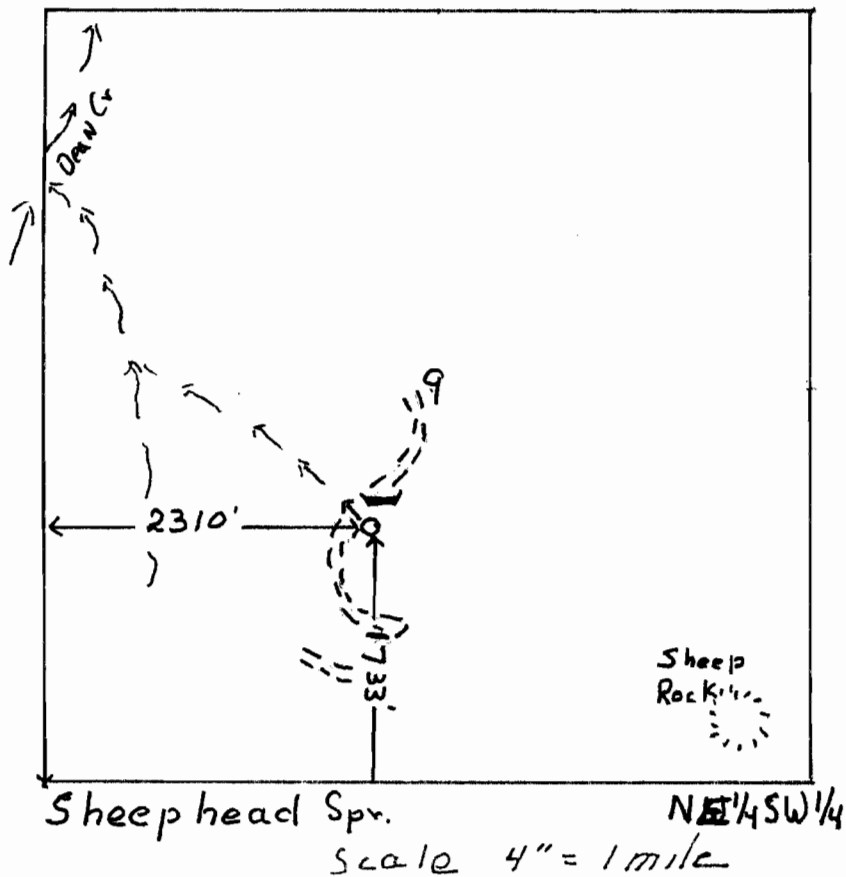

Application No. 66644

Permit No. 49805