


RECEIVED

T10S R38E W.M.

SEPT 2 1983

WATER RESOURCES DEPT.
SALEM, OREGON

Section N36

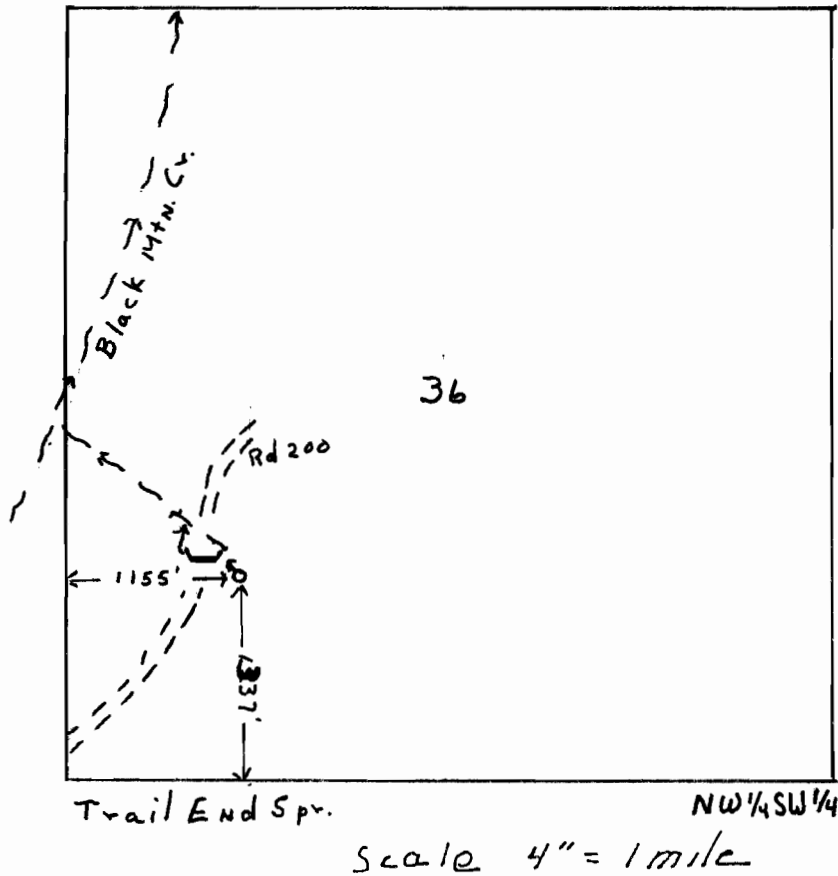

Application No. 66645
Permit No. 49806