


RECEIVED

SEPT 2 1983
WATER RESOURCES DEPT.
SALEM, OREGON

T 11 S R 37 E W.M.

Section 12

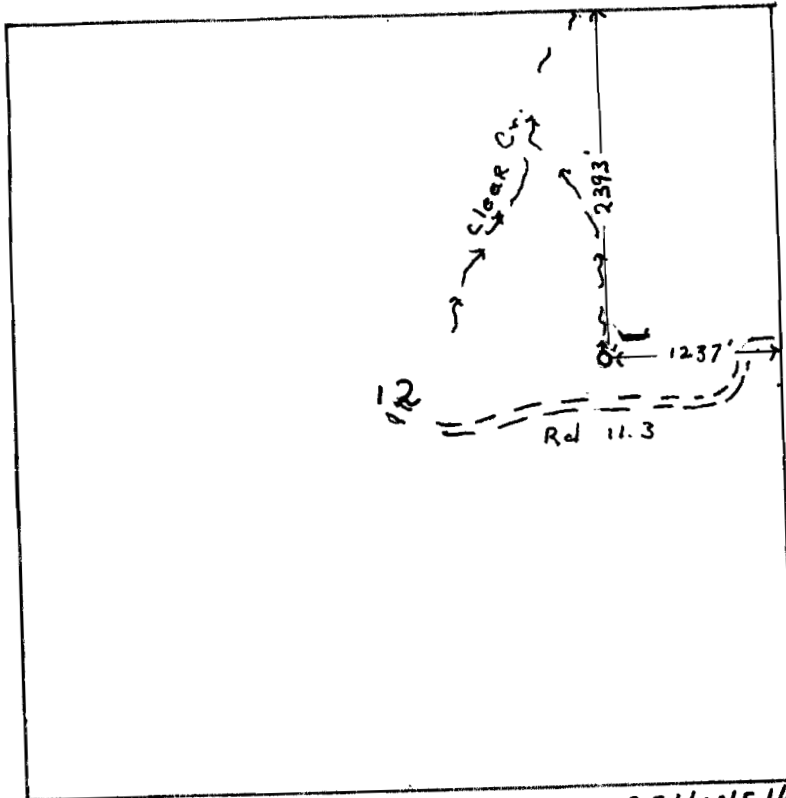

Jack McCord Spv.

SE 1/4 NE 1/4

Scale 4" = 1 mile

Application No.

66646

Permit No.

49807