


RECEIVED

SEP 2 1983

T 10 S R 37 E W.M. WATER RESOURCES DEPT.
SALEM, OREGON

Section 22

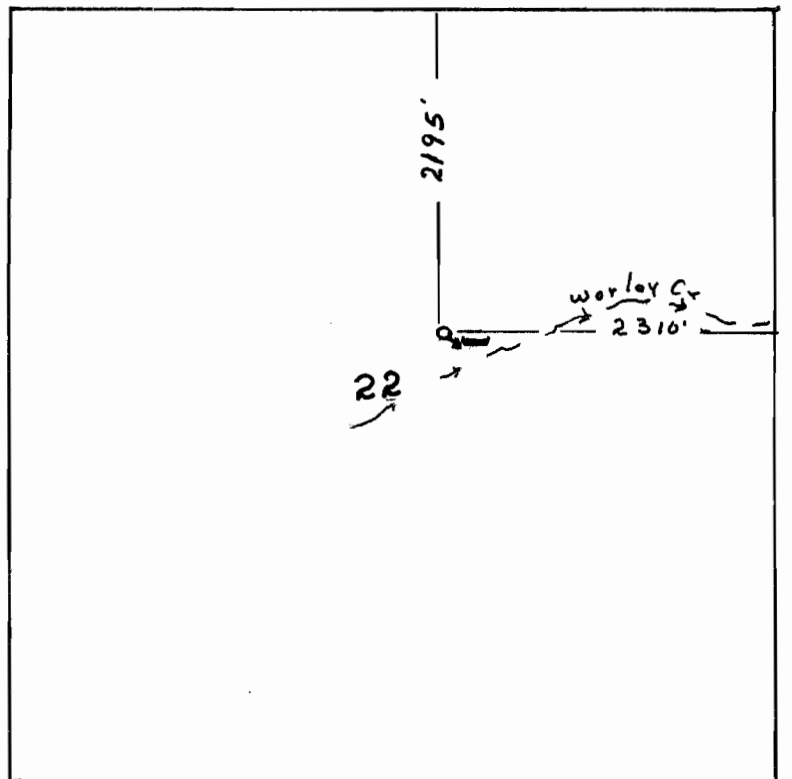

Worley Spv.

SW 1/4 NE 1/4

Scale 4" = 1 mile

Application No. 66647
Permit No. 49808