


RECEIVED

SEPT 2 1983

WATER RESOURCES DEPT.
SALEM, OREGON

T10-S R37E W.M.

Section N 22

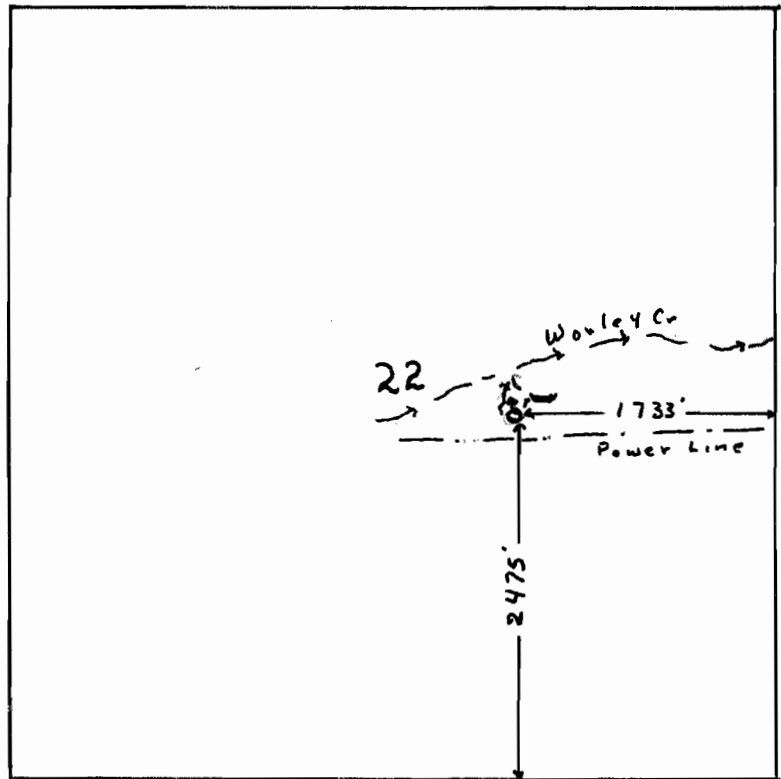

Power line Spr.

NE 1/4 SE 1/4

Scale 4" = 1 mile

Application No. 66648

Permit No. 49809