


RECEIVED
SEP 2 1983
WATER RESOURCES DEPT.
SALEM, OREGON

T10S R38E W.M.

Section 32

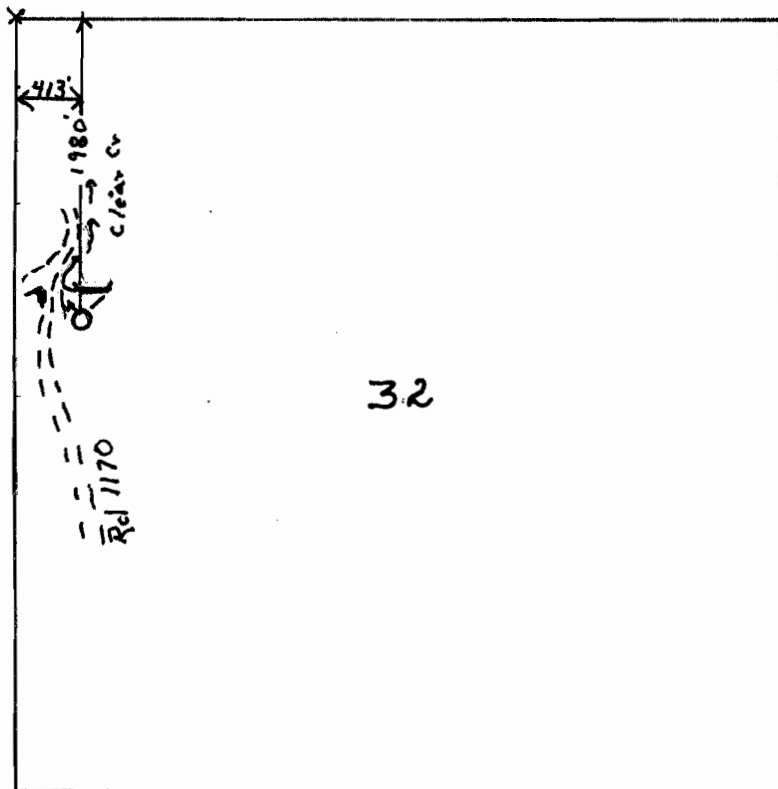

Adams Spring SW 1/4 NW 1/4
Scale 4" = 1 mile

Application No. 66650
Permit No. 49810