


T 11 S R 38 E W.M.

Section 8

RECEIVED

SEP 22 1983

WATER RESOURCES DEPT.
SALEM, OREGON

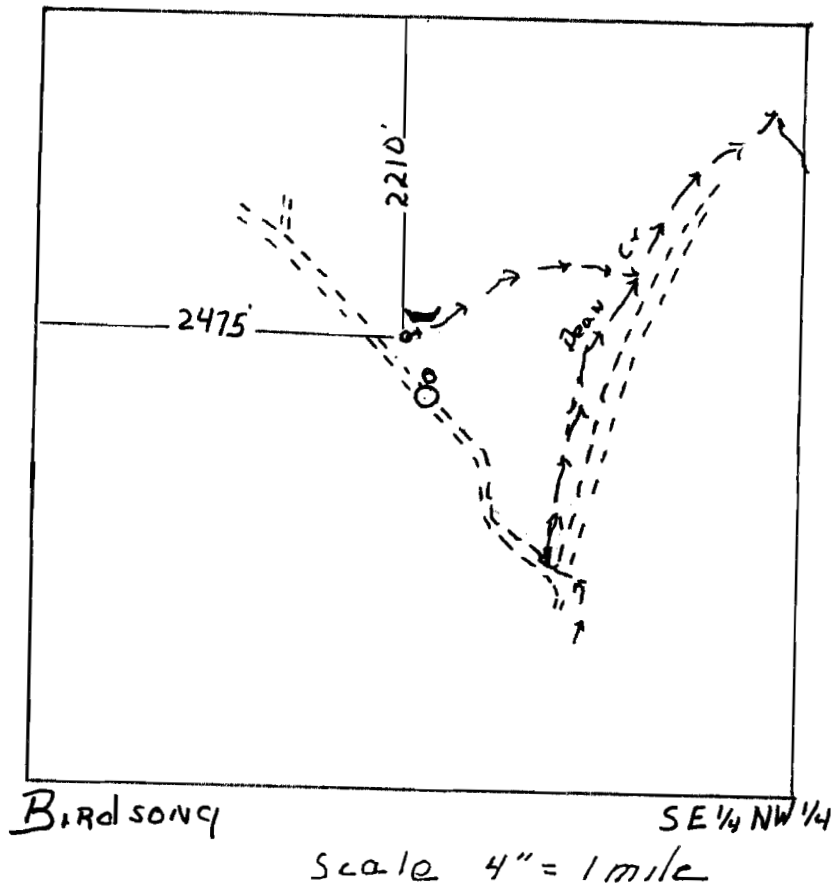

Application No. 66651
Permit No. 49811