


T11 S R38 E W.M.

Section 8

RECEIVED

SEP 2 1983
WATER RESOURCES DEPT.
SALEM, OREGON

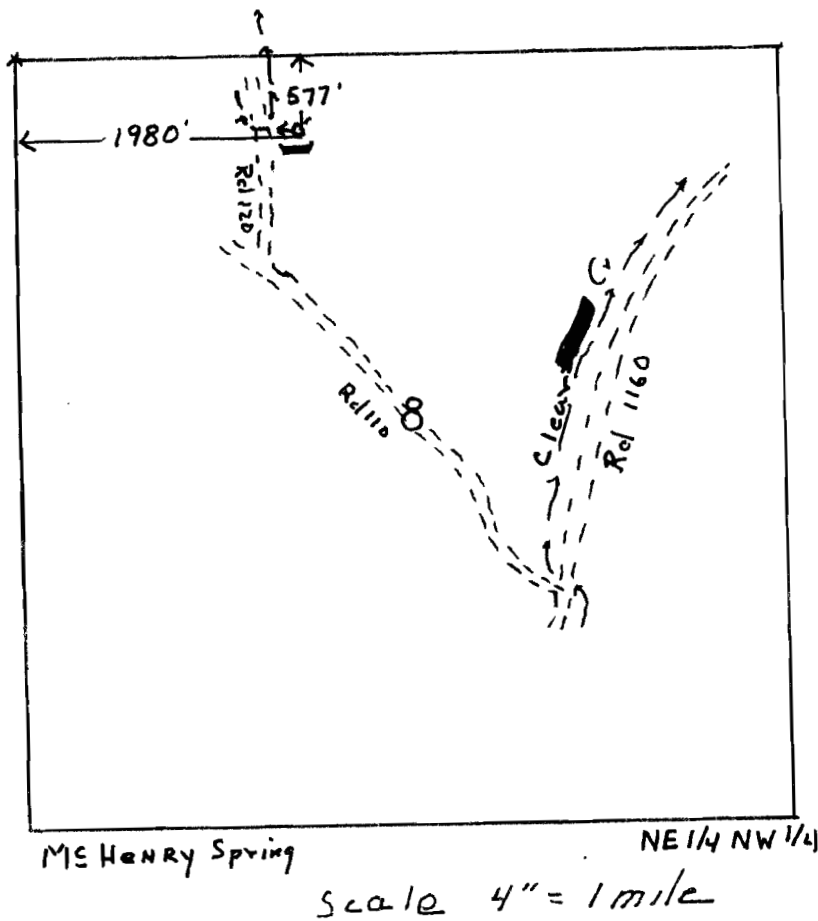

Application No. 66652
Permit No. 49812