


T 11 S R 38 E W.M.

Section 31

RECEIVED

SEP 2 1983

WATER RESOURCES DEPT.
SALEM, OREGON

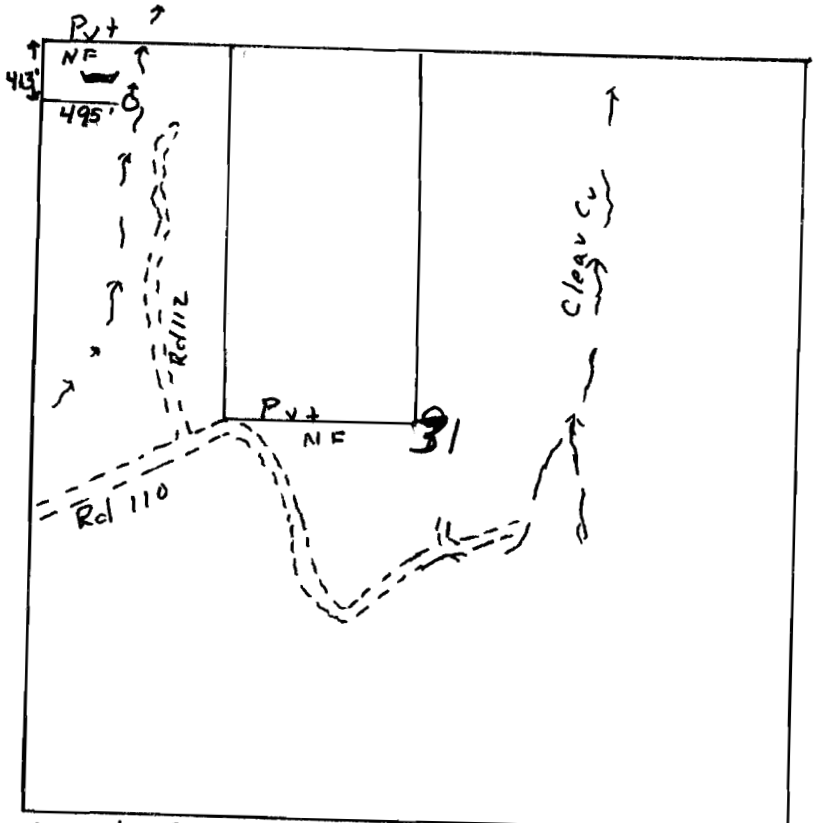

Moody Spr.

NW 1/4 NW 1/4

Scale 4" = 1 mile

Application No. 66653

Permit No. 49813