

ENGINEER
BY F.D.A.

1926

OREGON

10. 10967
7484

FROM OFFICE OF THE STATE

T. 6 S. R. 12 E



Scale of Feet.

C-7805

7484



ST. ENGINEER
RECEIVED

AUG 2 1926

SALEM, OREGON

Application No. 10967
Permit No. 7484

TSSR12E

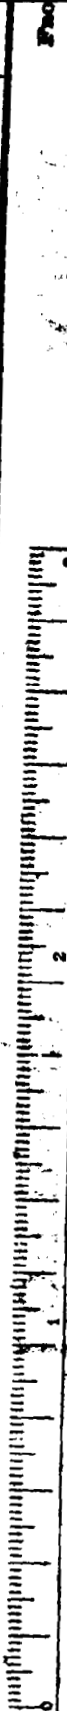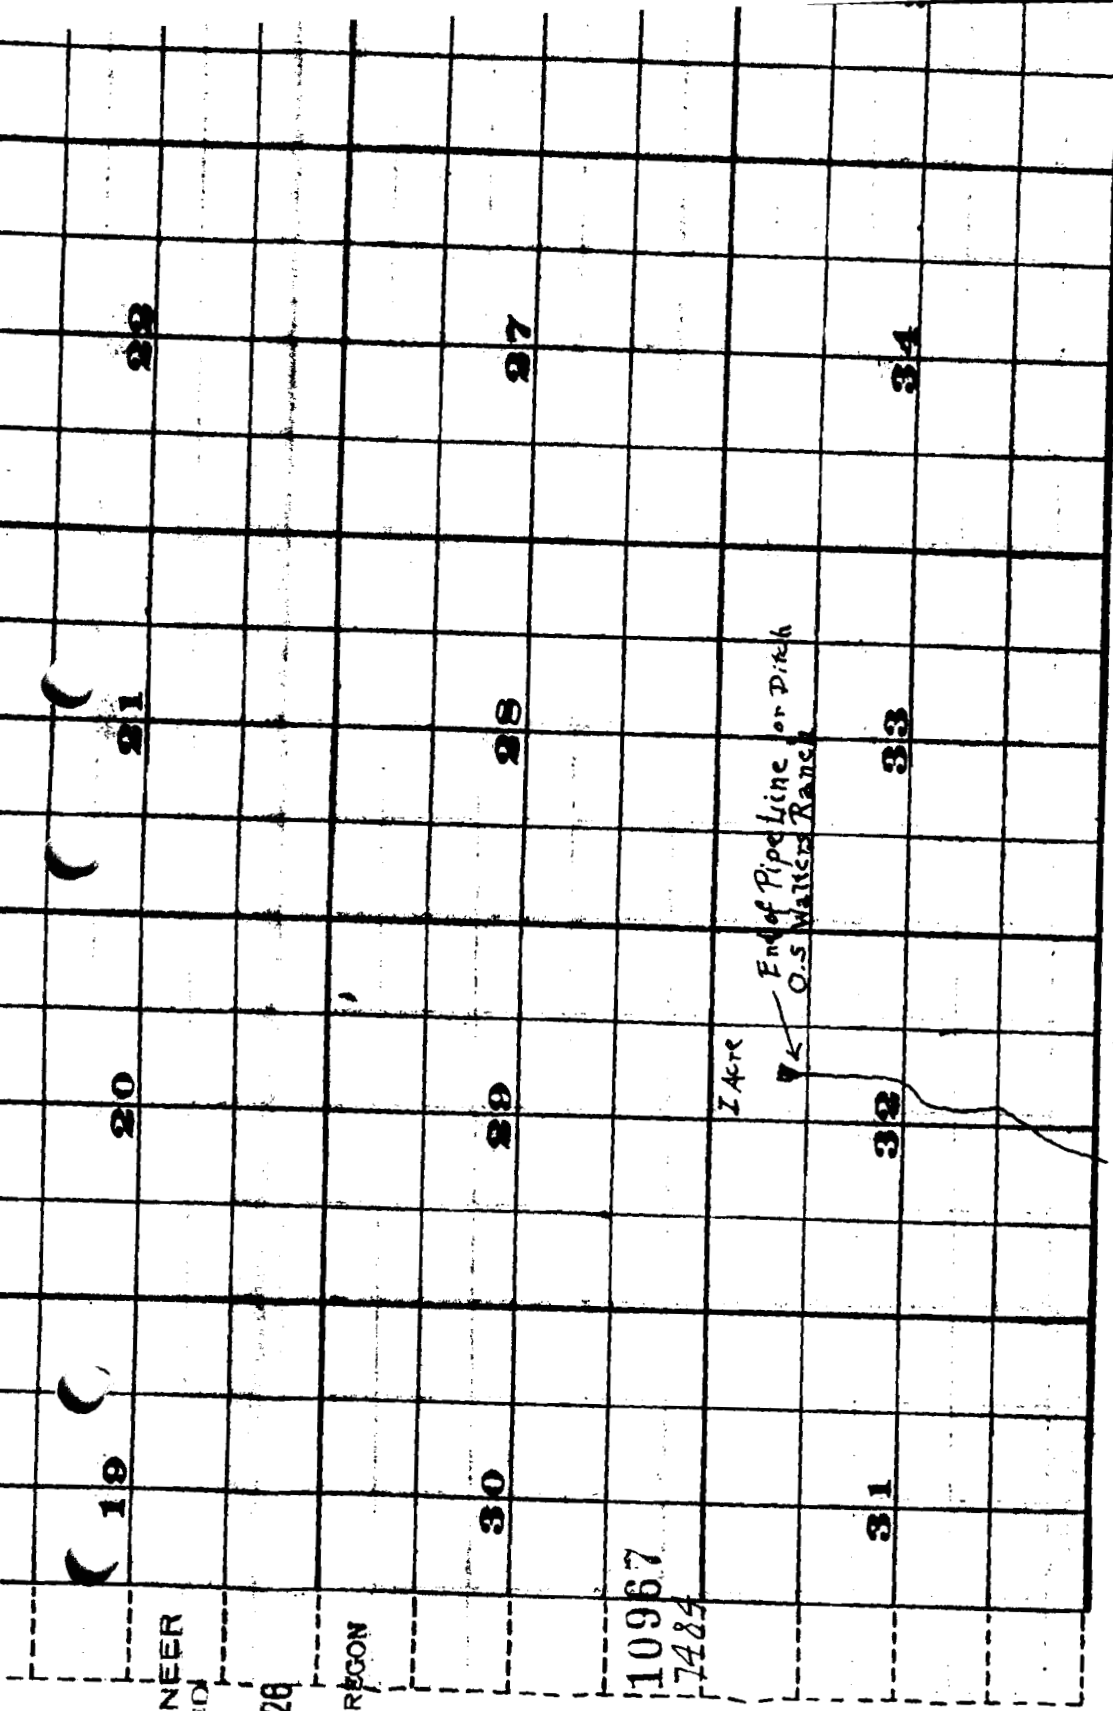

Scale of Feet.