

T11 S R38 E W.M.


Section 9

RECEIVED

SEP 2 1983

WATER RESOURCES DEPT.

SALEM, OREGON

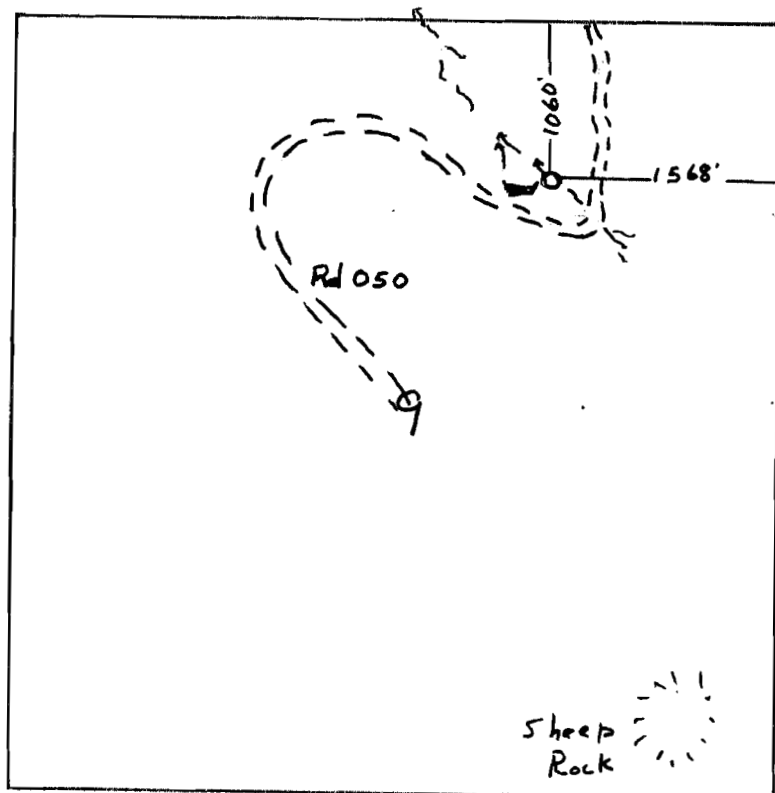

Thistle Springs

NW 1/4 NE 1/4

Scale 4" = 1 mile

Application No. 66654

Permit No. 49814