


T 5 S R 38 E W. M.

Section 28

RECEIVED

SEP 2 1983

WATER RESOURCES DEPT.
SALEM, OREGON

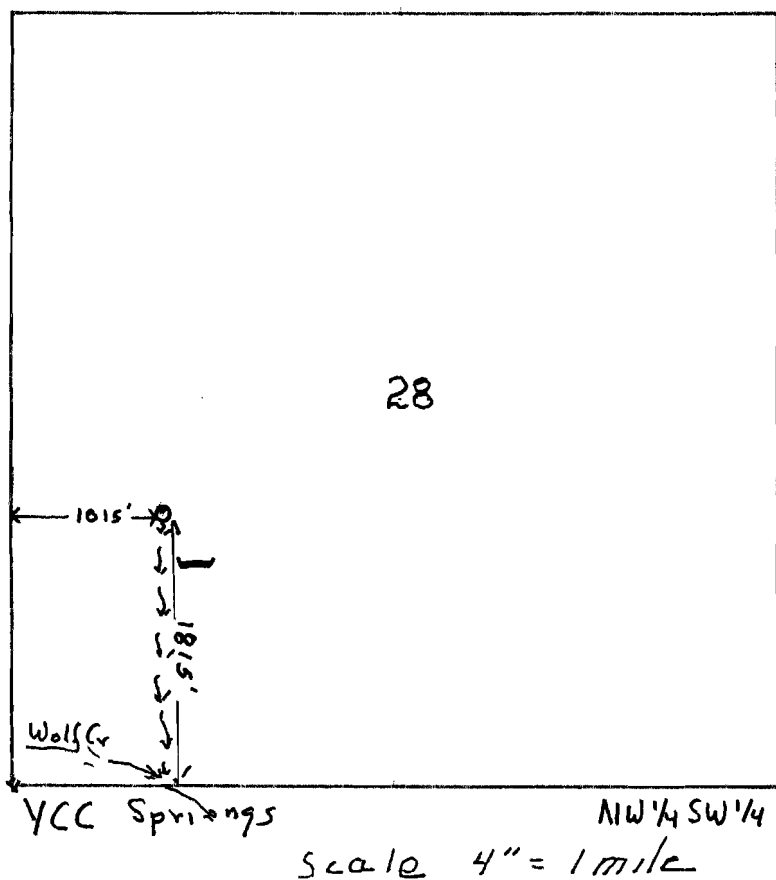

Application No. 66655

Permit No. 49815