


T 5 S R 38 E W.M.

Section 19

RECEIVED

SEP 2 1983

WATER RESOURCES DEPT.
SALEM, OREGON

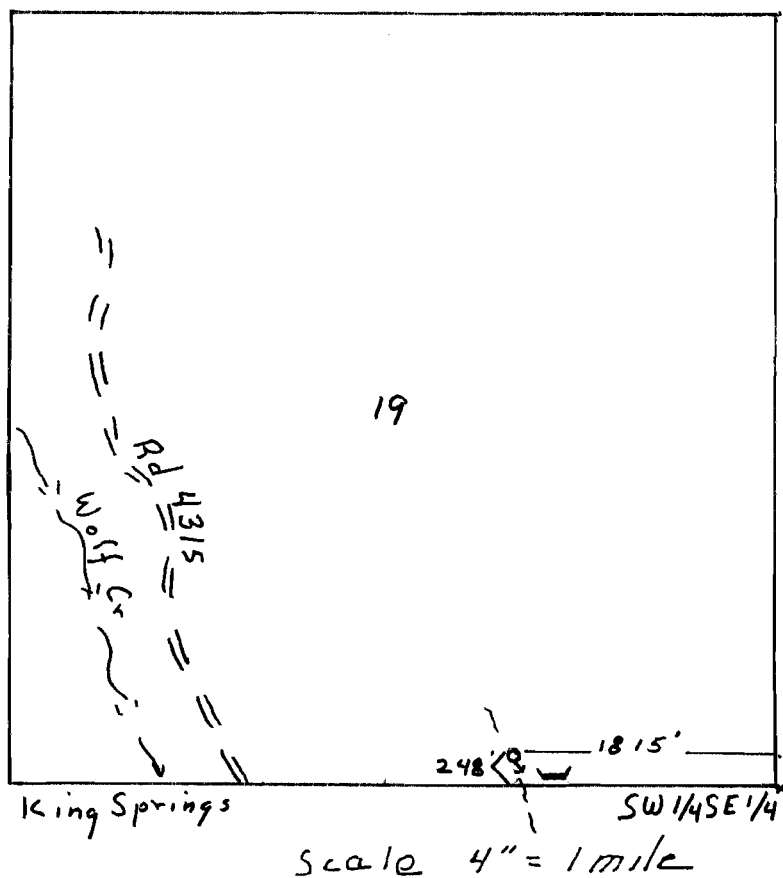

Application No. 66656
Permit No. 49816