


RECEIVED

T 5 S R 38 E W. M.

SEP 22 1983

LAND RESOURCES DEPT.
SALEM, OREGON

Section 27

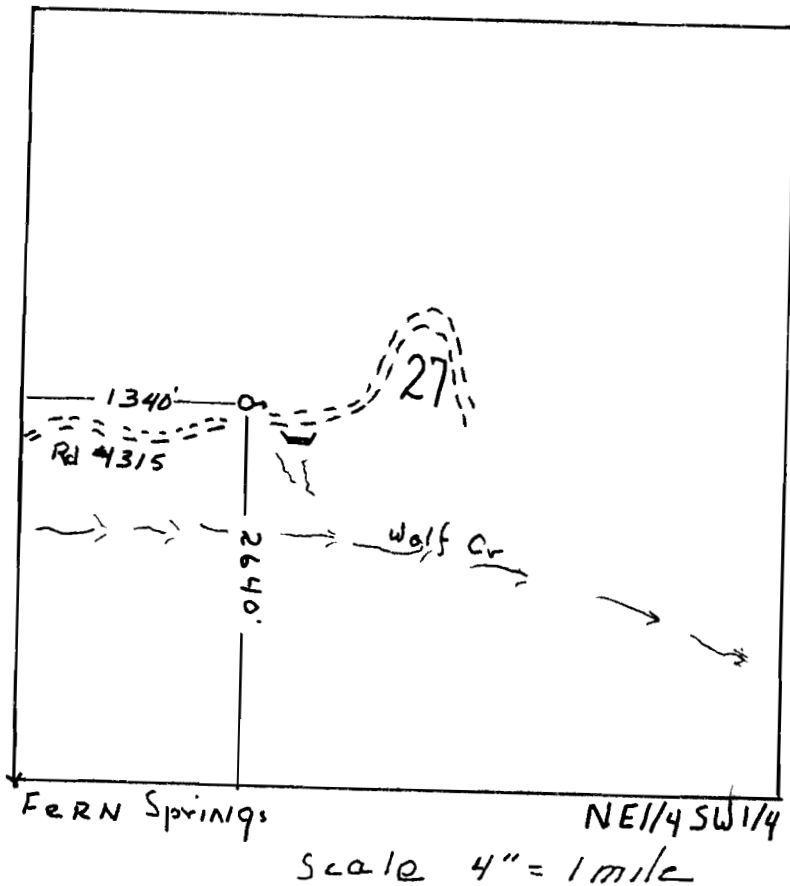

Application No. 66657

Permit No. 49817