


RECEIVED

SEP 2 1983

WATER RESOURCES DEPT.
SALEM, OREGON

T5 S R37E W.M.

Section 11

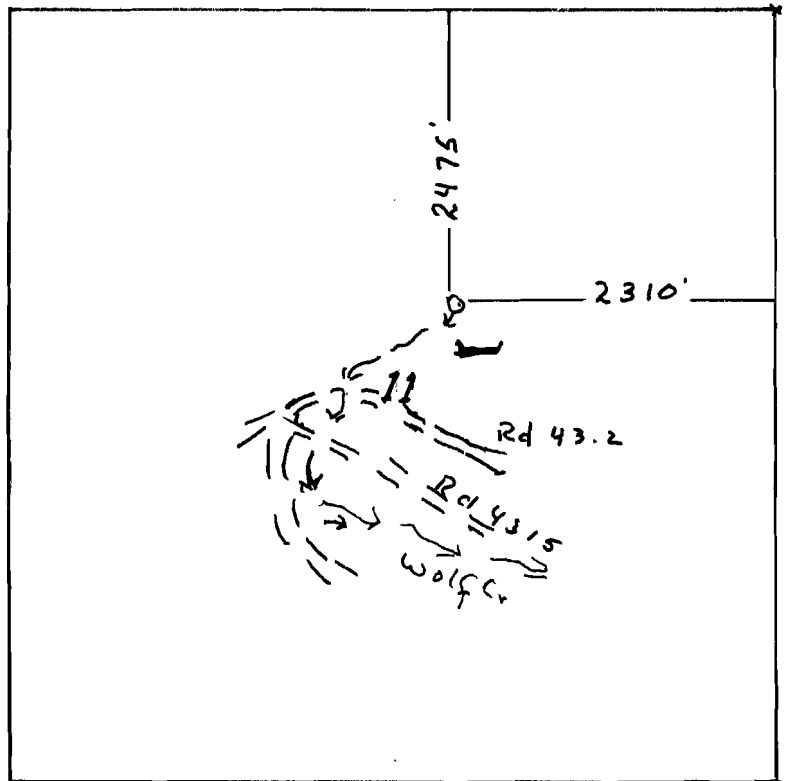

Wolfpack

SW 1/4 NE 1/4

scale 4" = 1 mile

Application No. 66658

Permit No. 49818