

RECEIVED


T 5 S R 37 E W.M.

SEP 22 1983

WATER RESOURCES DEPT.

SALEM, OREGON

Section 12

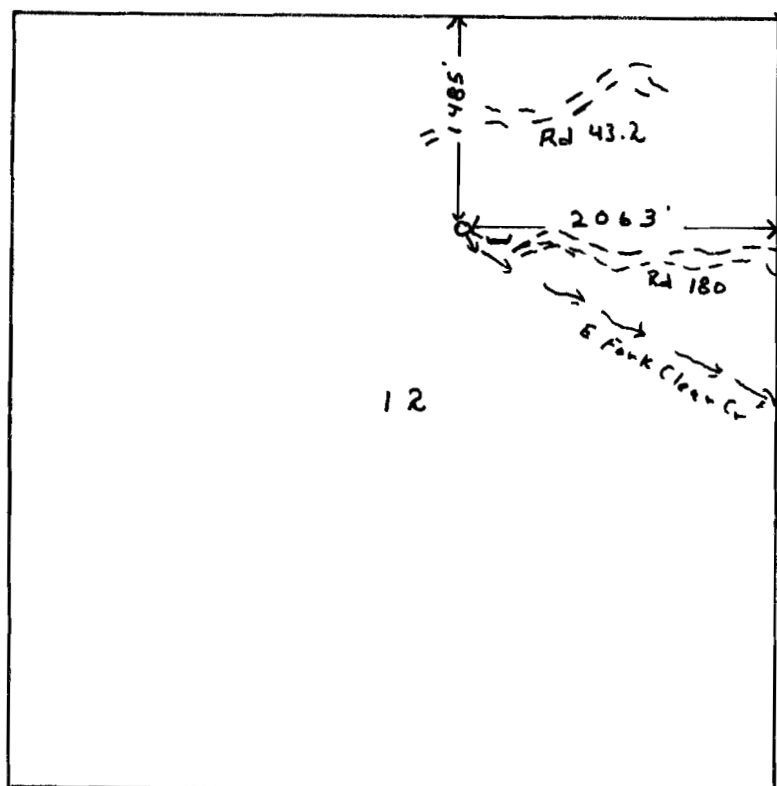

Goshawk

SW 1/4 NE 1/4

Scale 4" = 1 mile

Application No. 66659

Permit No. 49819