


T 5 S R 37 E W. M.

Section 112

RECEIVED

SEP 2 1983

WATER RESOURCES DEPT.
SALEM, OREGON

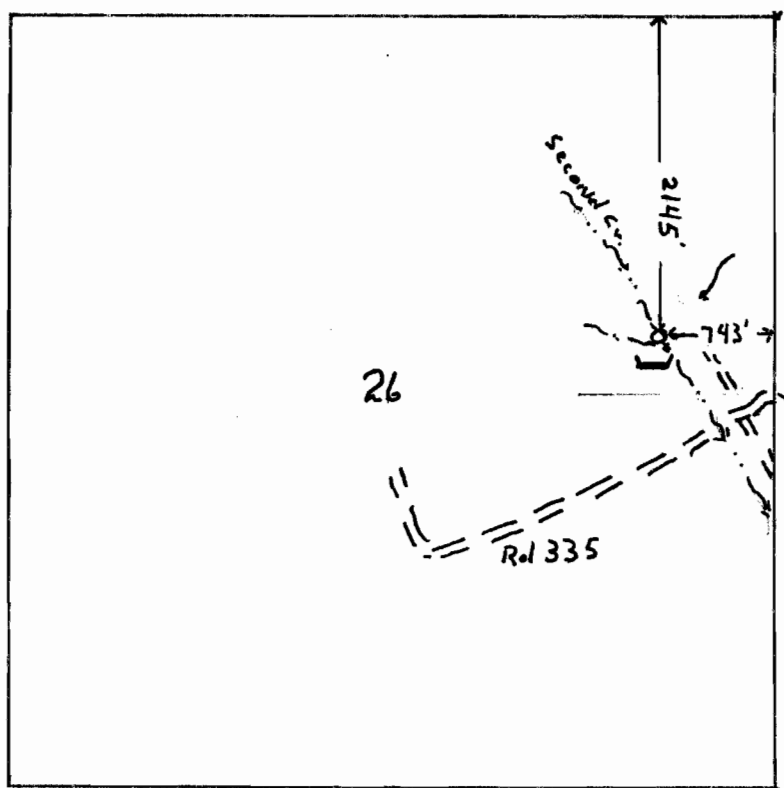

2nd Springs

SE 1/4 NE 1/4

Scale 4" = 1 mile

Application No. 66660

Permit No. 49820