


T 9 S R 37 E W.M.

Section 28

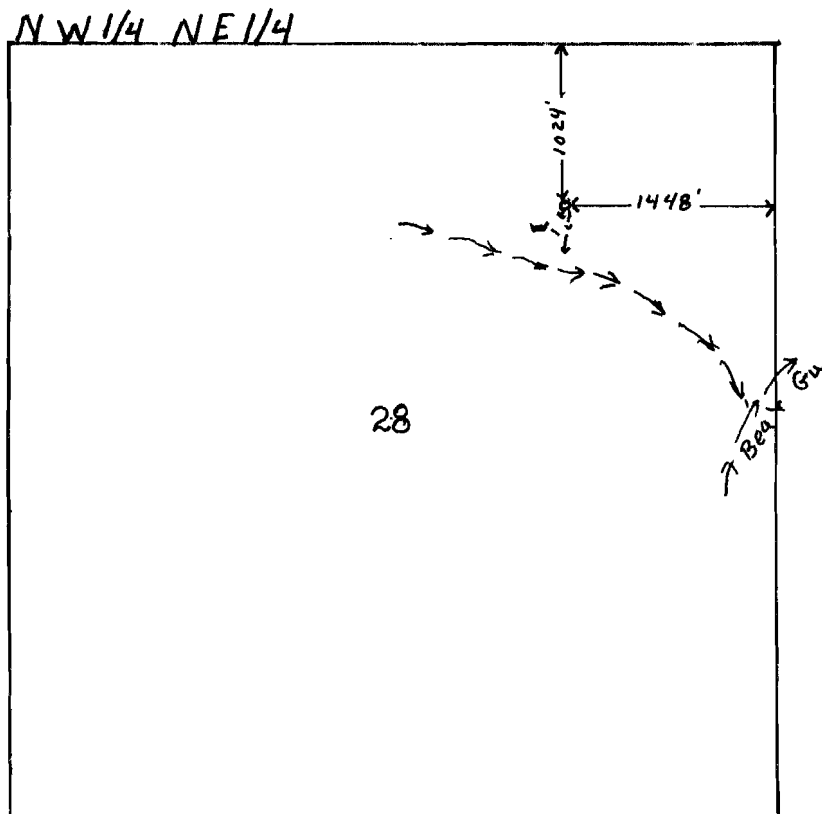

—YC Spr.

Scale 4" = 1 mile

Application No. 65720
Permit No. 50458

RECEIVED

APR 29 1982
NATURAL RESOURCES DEPT
SALEM, OREGON