


T 9 S R 37 E W.M.

Section 14

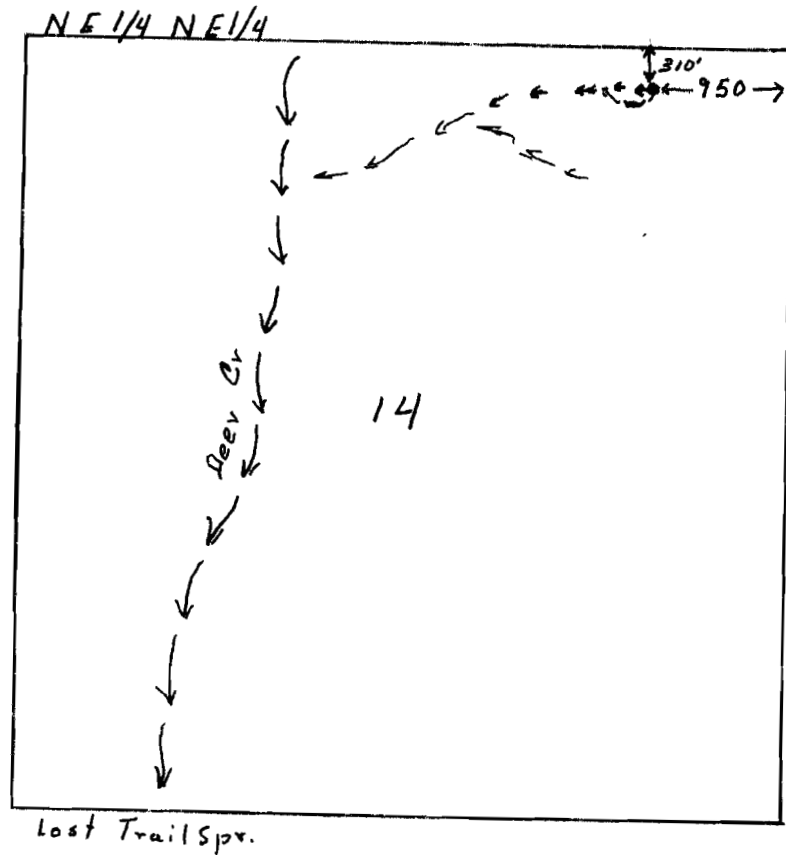

Scale 4" = 1 mile

Application No. 65720

Permit No. 50459

RECEIVED

APR 29 1982

LAND RESOURCES DEPT
SALEM, OREGON