


T 9 S R 37 E W.M.

Section 14

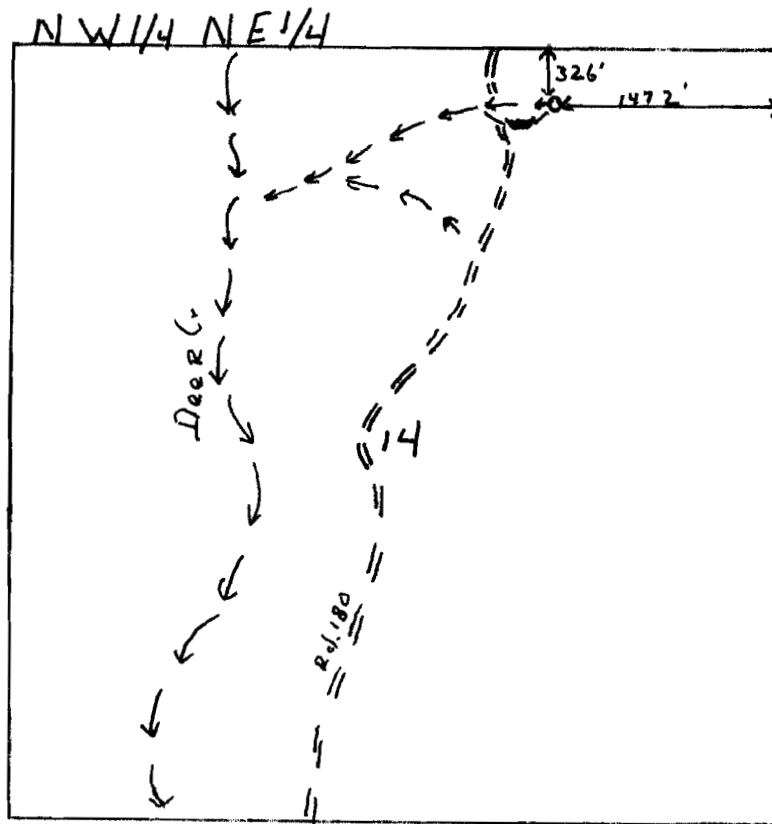

Washout Spr.

Scale 4" = 1 mile

Application No. 65722

Permit No. 50460

RECEIVED

APR 29 1983

WILDERNESS RESOURCES DEPT
SALEM, OREGON