


T 9 S R 38 E W.M.

Section 15

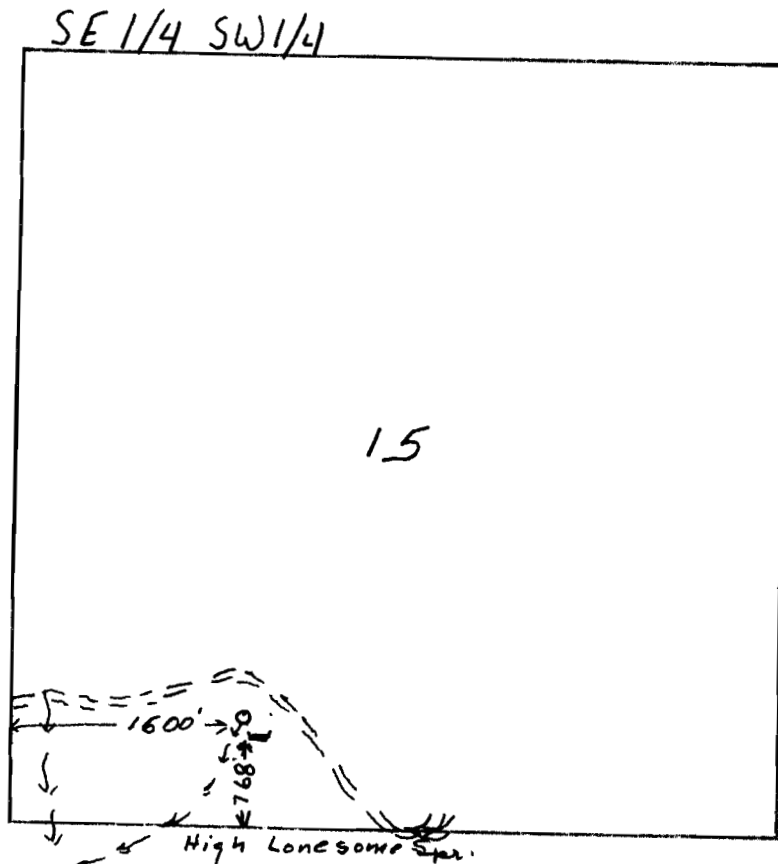

Scale 4" = 1 mile

RECEIVED

APR 29 1987
WATER RESOURCES DEPT
SALEM, OREGON

Application No. 65724

Permit No. 50461