


T9 S R37E W.M.

Section 24

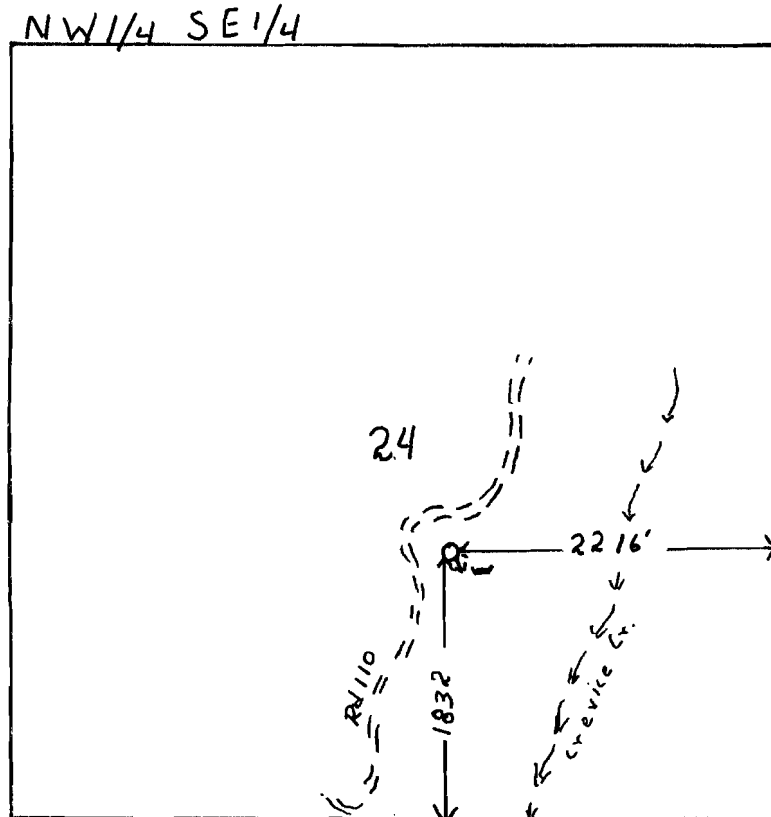

Sedge Spr.

scale 4" = 1 mile

Application No. 65725

Permit No. 50462

RECEIVED

APR 29 1915
LAND RESOURCES DEPT
SALEM, OREGON