


T 9 S R 37 E W.M.

Section 13

SW 1/4 SE 1/4

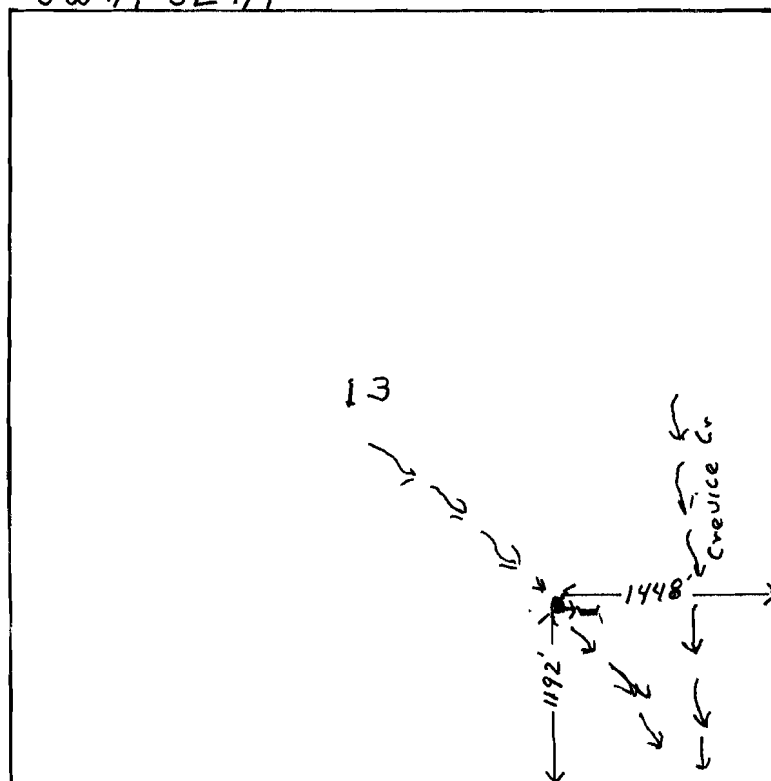

Clear water Spr.

Scale 4" = 1 mile

RECEIVED

APR 29 1987

LAND REVENUE DEPT
SALEM, OREGON

Application No. 65726

Permit No. 50463