


T 9 S R37 E W.M.

## Section 13

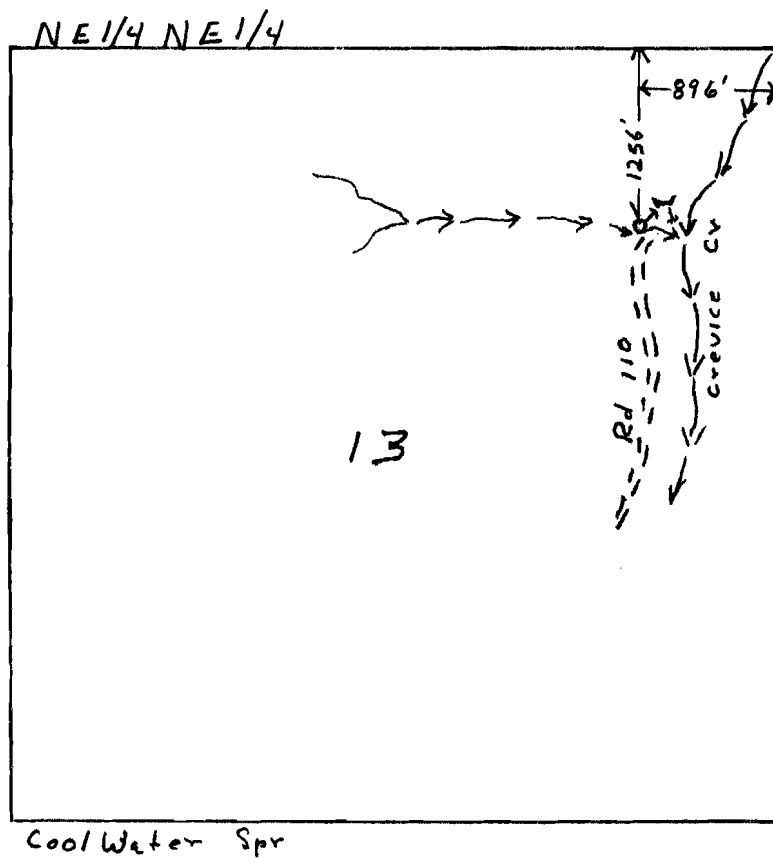

Scale  $4'' = 1 \text{ mile}$

**DECLASSIFIED**

APR 29 1980

SALEM, OREGON

Application No. 65727

Permit No. 50464