


T 9 S R 37 E W.M.

Section 10

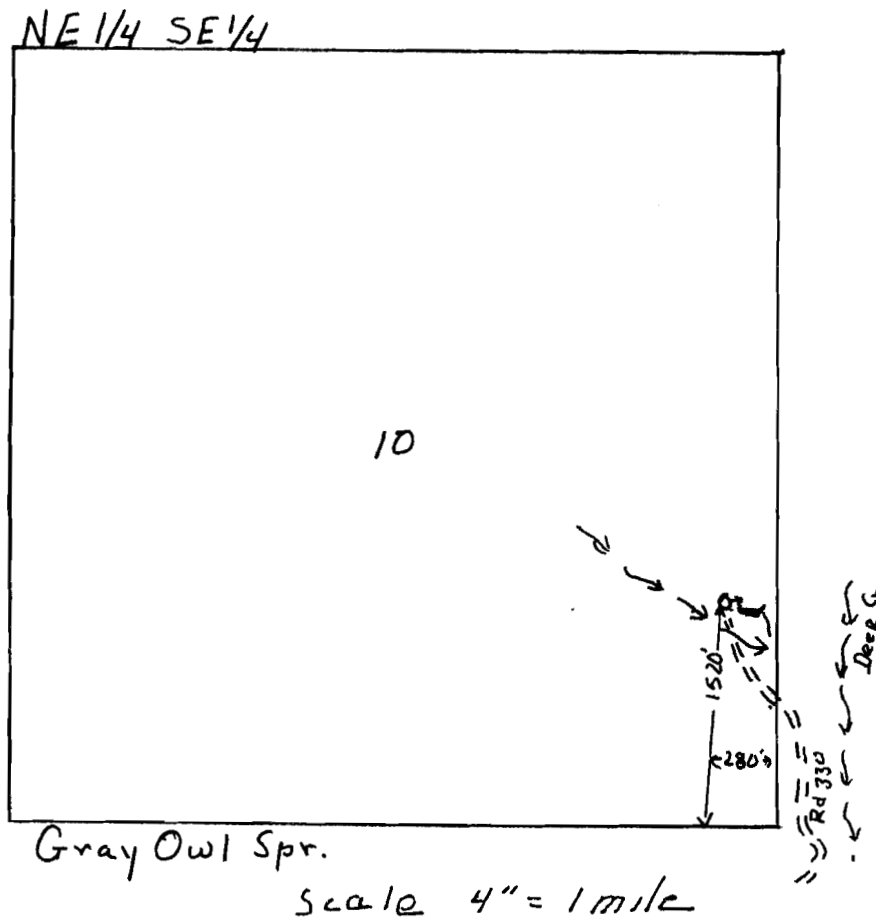

Application No. 65728

Permit No. 50465

RECEIVED

APR 9 1987

LAND REVENUE DEPT
SALEM, OREGON