


T 9 S R 37 E W.M.

Section 15

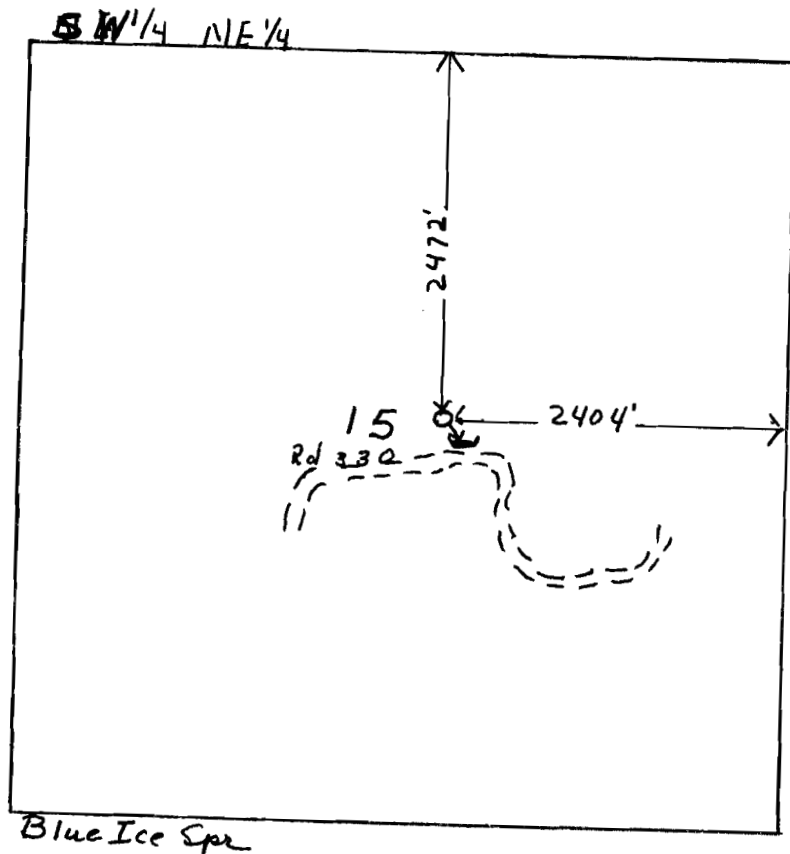

Scale 4" = 1 mile

Application No. 65729

Permit No. 50466

RECEIVED

APR 29 1987

U.S. FOREST SERVICE DEPT
SALEM, OREGON