


T 9 S R 37 E W.M.

Section 2

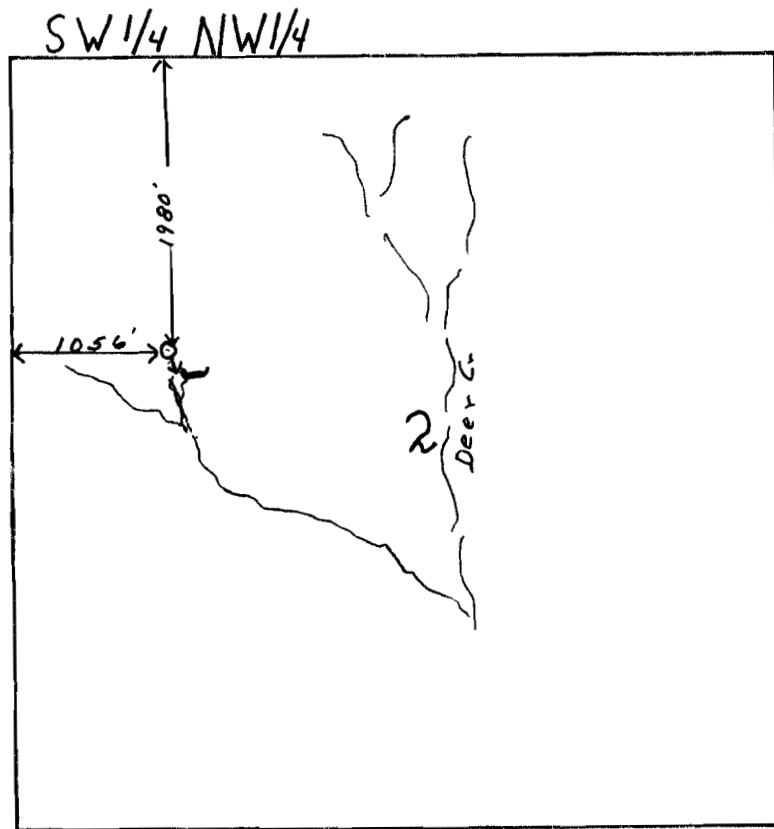

Snowshoe Spr.

Scale 4" = 1 mile

RECEIVED

APR 29 1987

WATER RESOURCES DEPT
SALEM, OREGON

Application No. 65730

Permit No. 50467