


T 9 S R 37 E W.M.

Section 2

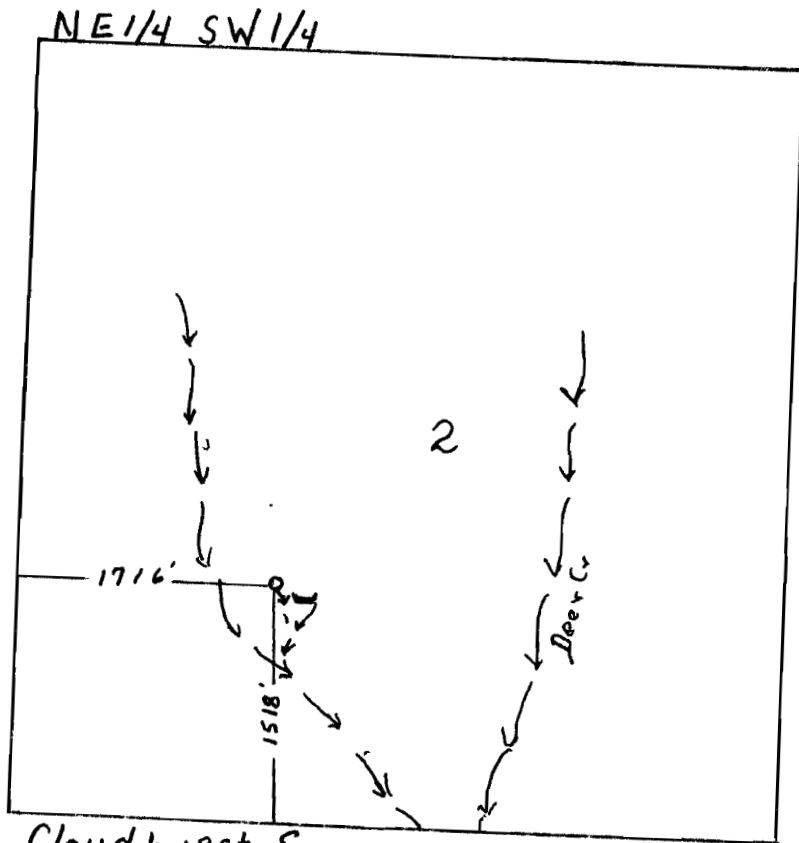

Scale 4" = 1 mile

RECEIVED

APR 29 1980

LAND REVENUE DEPT
SALEM, OREGON

Application No. 65731

Permit No. 50468