


T 9 S R 38 E W.M.

Section 22

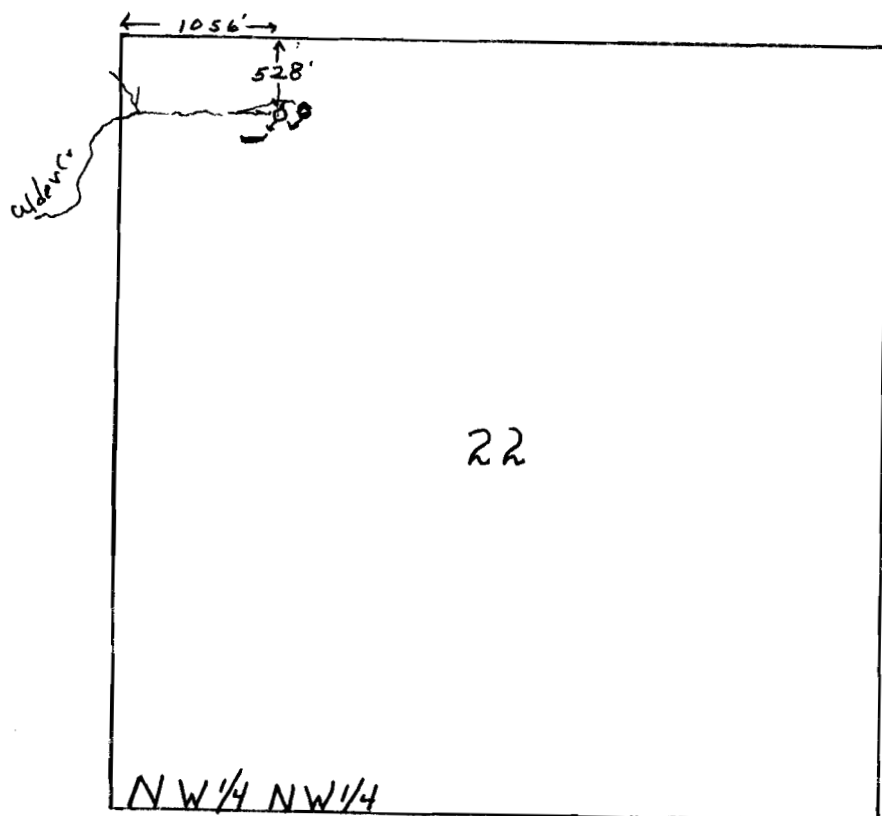

Two Alder Spr.

Scale 4" = 1 mile

Application No. 65732

Permit No.

50469

RECEIVED

APR 29 1980

WATER RESOURCES DEPT
SALEM, OREGON