


RECEIVED
APR 29 1980
WATER RESOURCES DEPT
SALEM, OREGON

T 9 S R 37 E W.M.

Section 15

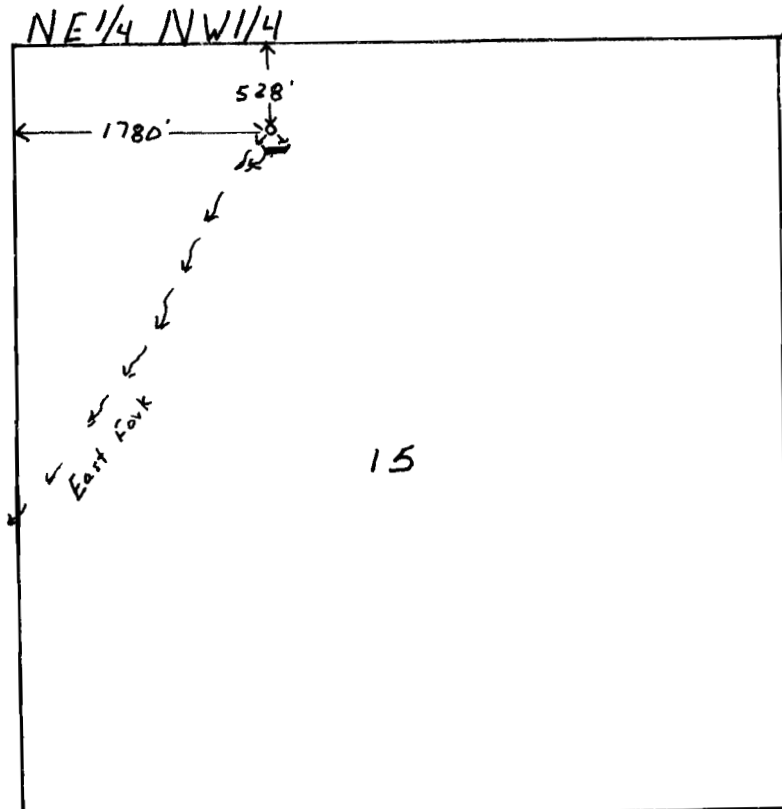

Pinegrass Spr

Scale 4" = 1 mile

Application No. 65733

Permit No. 50470